


75 COOLAWIN ROAD, NORTHBRIDGE  
ALTERATIONS & ADDITIONS

DRAWING REGISTER:

Drawing No.	Revision	Date	Title
2020-031-A1001	H	24.05.2022	SITE PLAN & BASIX REQUIREMENTS
2020-031-A1101	H	24.05.2022	LOWER GROUND FLOOR PLAN & REAR TERRACE
2020-031-A1102	H	24.05.2022	GROUND FLOOR PLAN
2020-031-A1103	H	24.05.2022	FIRST FLOOR PLAN
2020-031-A1104	H	24.05.2022	ROOF PLAN
2020-031-A1201	H	24.05.2022	SECTIONS
2020-031-A1202	H	24.05.2022	SECTIONS
2020-031-A1301	H	24.05.2022	ELEVATIONS
2020-031-A1302	H	24.05.2022	ELEVATIONS
2020-031-A1303	H	24.05.2022	ELEVATIONS
2020-031-A1304	H	24.05.2022	ELEVATIONS
2020-031-A1401	H	24.05.2022	FLOOR AREA & IMPERVIOUS AREA CALCULATIONS
2020-031-A1402	H	24.05.2022	SITE MANAGEMENT PLAN
2020-031-A1403	H	24.05.2022	NATURAL LANDSCAPED AREA CALCULATION PLAN
2020-031-A1501	H	24.05.2022	SOLAR EYE DIAGRAMS
2020-031-A1502	H	24.05.2022	SOLAR EYE DIAGRAMS
<del>2020-031-A1503</del>	<del>H</del>	<del>24.05.2022</del>	<del>SOLAR EYE DIAGRAMS</del>
<del>2020-031-A1504</del>	<del>H</del>	<del>24.05.2022</del>	<del>SOLAR EYE DIAGRAMS</del>
2020-031-A1511	H	24.05.2022	SHADOW DIAGRAMS
2020-031-A1512	H	24.05.2022	SHADOW DIAGRAMS
2020-031-A1513	H	24.05.2022	SHADOW DIAGRAMS
<del>2020-031-A1601</del>	<del>H</del>	<del>24.05.2022</del>	<del>DRIVEWAY SECTION</del>
2020-031-A2001	H	24.05.2022	FLAT ROOF - 3D & SECTIONS
2020-031-A2011	H	24.05.2022	FLAT ROOF - SOLAR EYE DIAGRAMS
2020-031-A2012	H	24.05.2022	FLAT ROOF - SOLAR EYE DIAGRAMS
2020-031-A2013	H	24.05.2022	FLAT ROOF - SOLAR EYE DIAGRAMS
2020-031-A2014	H	24.05.2022	FLAT ROOF - SOLAR EYE DIAGRAMS
<del>2020-031-N1000</del>	<del>H</del>	<del>24.05.2022</del>	<del>NOTIFICATION PLAN</del>

Drawing No.	Revision	Date	Title
2020-031-A3001	H	24.05.2022	STREETVIEW 3D
2020-031-A3002	H	24.05.2022	STREETVIEW 3D
2020-031-A3011	H	24.05.2022	STREETSCAPE ELEVATION
2020-031-A3021	H	24.05.2022	STREETVIEW IMAGE
2020-031-A3022	H	24.05.2022	STREETVIEW IMAGE
2020-031-A3023	H	24.05.2022	STREETVIEW IMAGE

ARCHITECT

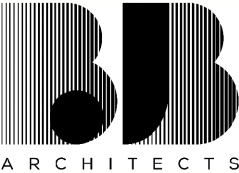

t: 02 8970 5417  
e: studio@bjbarchitects.com.au  
a: 3.09/77 Dunning Ave  
Rosebery NSW 2018

BJB Architects Pty Ltd  
Nominated Architect:  
Barry Babikian NSW Reg No 8806


ISSUE	AMENDMENT	DATE
E	Development Application	13.10.2020
F	DA Amendment	12.04.2021
G	Amendment - LEC	10.05.2022
H	Amendment - LEC	24.05.2022

PROJECT  
75 COOLAWIN ROAD,  
NORTHBRIDGE  
NEW DWELLING

COVER PAGE  
SCALE: DATE: 24.05.2022  
ISSUE: H - Amendment - LEC

THIS DOCUMENT IS THE COPYRIGHT OF BJB ARCHITECTS.  
ALL INFORMATION ILLUSTRATED ON THIS DOCUMENT IS  
TO BE CHECKED AND VERIFIED ON SITE.  
IN THE EVENT OF DISCREPANCIES REFER TO BJB  
ARCHITECTS PRIOR TO COMMENCEMENT OF THE WORK.  
DO NOT SCALE DRAWINGS MANUALLY OR  
ELECTRONICALLY.

2020-031  
A1000

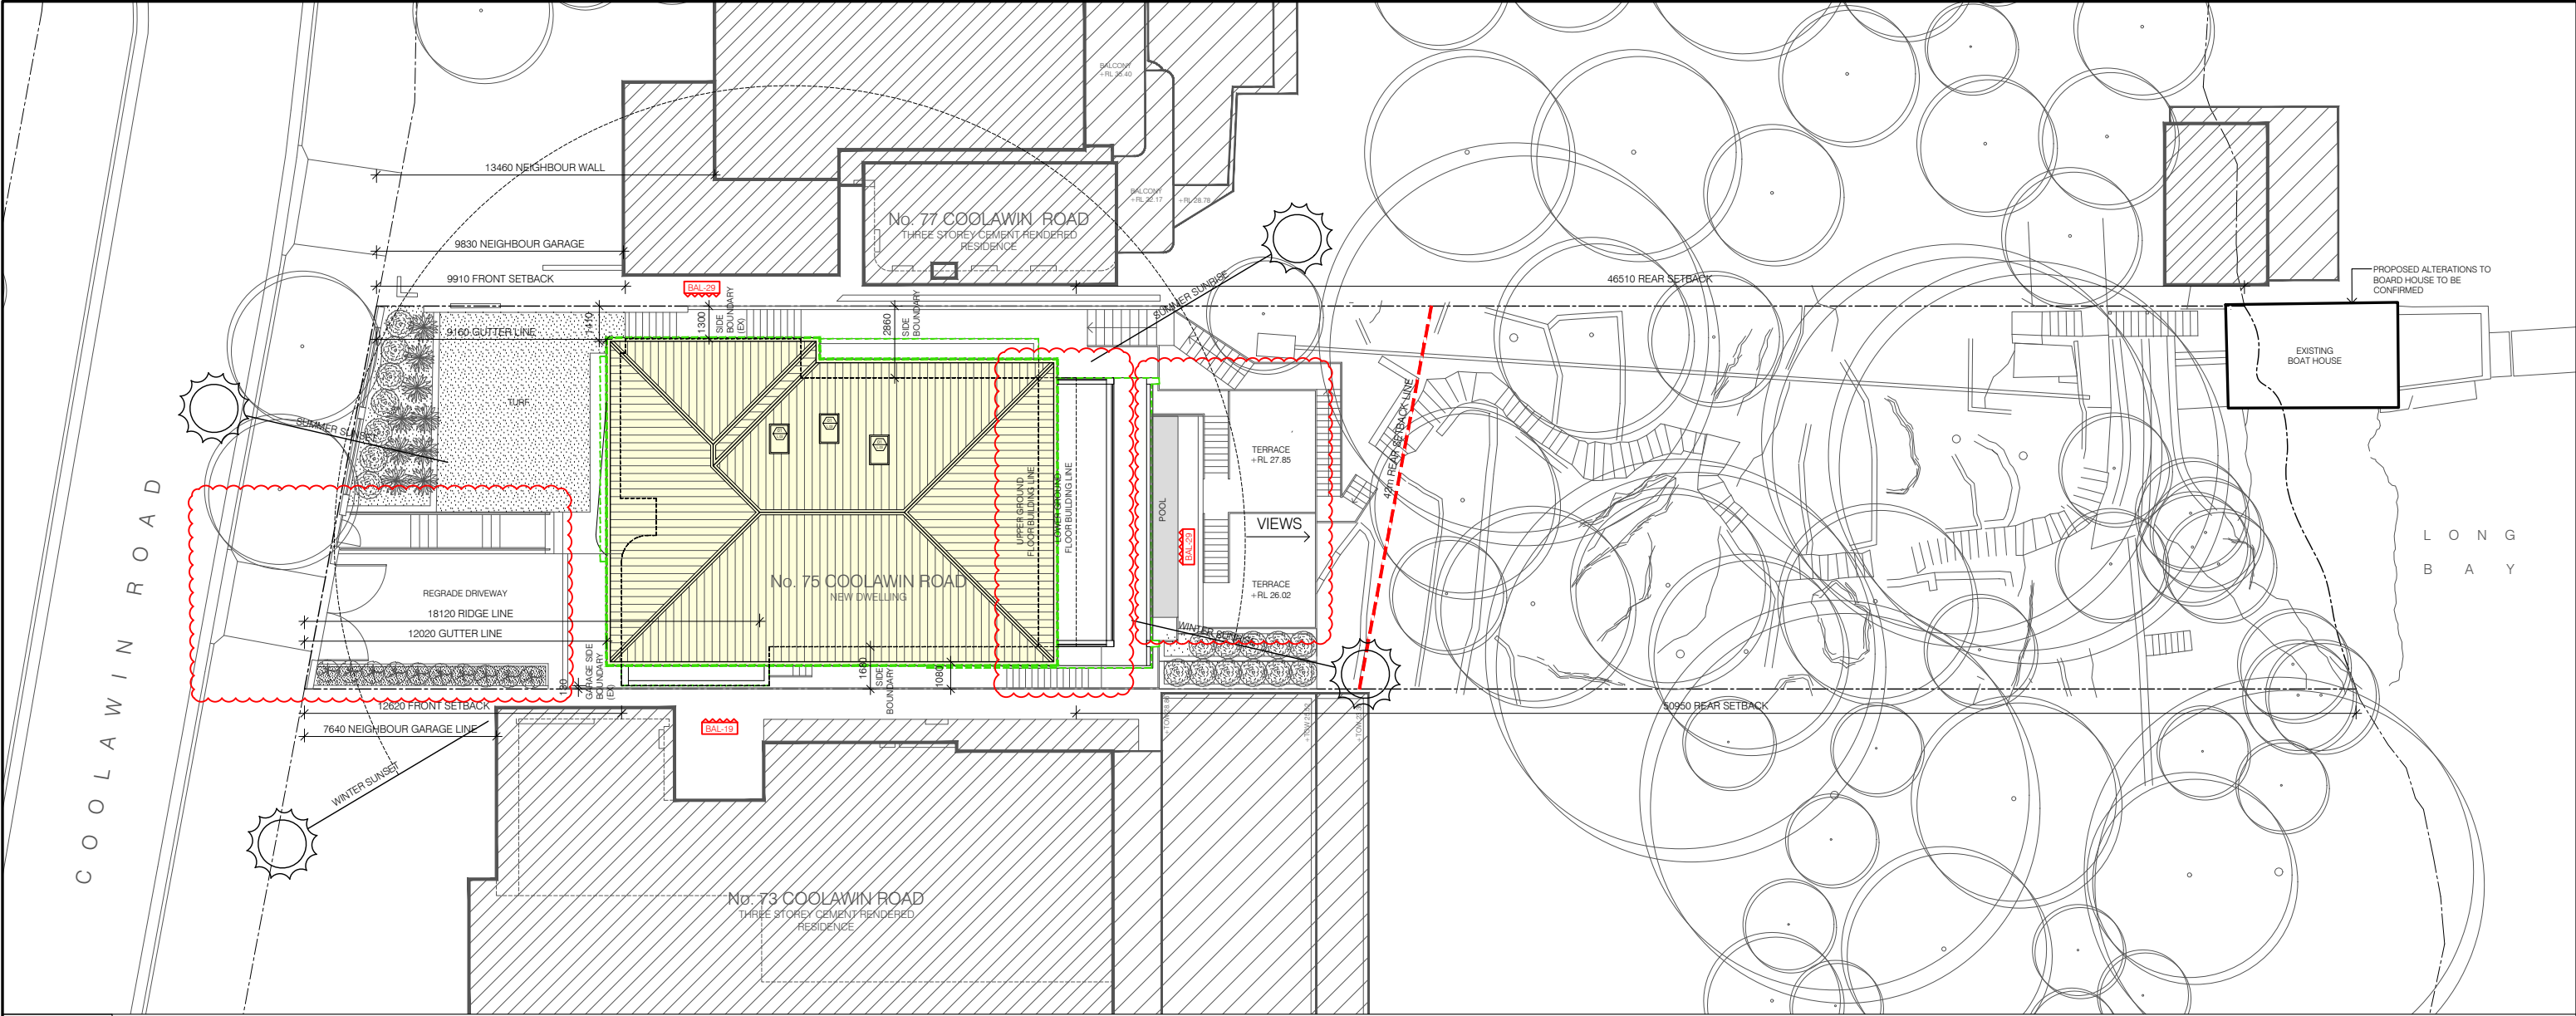

BASIX

- LANDSCAPE:**
- Indigenous or low water use species of vegetation throughout 350 sqm of site
- FIXTURE:**
- Showerheads: min 4 star (>6 but <= 7.5L/min)
  - Toilet: min 4 star
  - Taps: min 4 star
  - Basin taps: min 4 star
- ALTERNATIVE WATER:**
- RAINWATER TANK:**
- Min 6000 litres rainwater tank
  - To collect rain runoff from at least 250sqm of roof area
  - Tank to connect to:
    - a. all toilets
    - b. the cold water tap that supplies each clothes washer at least one outdoor tap
    - c. a tap that is located within 10 metres of the swimming pool
    - d. a tap that is located within 10 metres of the outdoor spa
    - e. a tap that is located within 10 metres of the outdoor spa
- SWIMMING POOL:**
- Max volume of 42 kilolitres
  - Must be outdoors
- OUTDOOR SPA:**
- Max volume of 4.5 kilolitres

THERMAL COMFORT COMMITMENTS:		
Floor	Concrete slab on ground	Location Lower ground level
	Suspended concrete slab on R2.0 insulation	Ground level to subfloor
	Concrete slab	Lower ground level
Walls		
External Wall	Cavity masonry wall with 25mm foilboard in cavity	
Internal Wall	Single skin brick	
Ceilings		
	Plasterboard with R3.5 insulation added	Location Ceilings beneath roof and under slab to external air above
	Plasterboard	Elsewhere
Roof		
	Light coloured metal sheet on R1.0 anticon blanket reflective side down	Location Ground & first level
	Waterproofed concrete	Lower ground level
Glazing		
• Aluminium framed single clear, AFRC rating U<= 6.7, SHGC 0.70+-5%		Location W01L00, W01L01, W06L01, D06L01, W02L02, W03L02, W04L02, W06L02, W07L02, D01L02, D01L00, W08L02
• Aluminium framed argon filled double clear, AFRC rating U<= 4.5, SHGC 0.61+-5%		All other hinged doors and awning windows
• Aluminium framed argon filled double clear, AFRC rating U<= 4.5, SHGC 0.50+-5%		All other fixed and sliding glazing
Skylight:		
Double clear		

- ENERGY COMMITMENTS:**
- HOT WATER:**
- Solar (gas boosted, flat plate) with a performance of 26 to 30 STCs or better
- COOLING & HEATING SYSTEM:**
- Min 1 living area: 3-phase airconditioning; Energy rating: EER 2.5 - 3.0
  - Min 1 bedroom: 3-phase airconditioning; Energy rating: EER 2.5 - 3.0
  - Cooling/ heating system must provide for day/ night zoning between living areas & bedrooms.
- VENTILATION:**
- Min 1 Bathroom: individual fan, ducted to facade; Operation control: manual switch on/off
  - Kitchen: individual fan, ducted to facade; Operation control: manual switch on/off
  - Laundry: individual fan, ducted to facade; Operation control: manual switch on/off
- ARTIFICIAL LIGHTING:**
- Recessed downlights to be LED fixtures which seal against air leakage through the ceiling
  - a. Min 6 bedrooms/ study
  - b. Min 1 living/ dining rooms
  - c. Kitchen
  - d. All bathrooms/ toilets
  - e. Laundry
  - f. Hallways


- NATURAL LIGHTING:**
- Window and/ or skylight must be installed in the kitchen and 4 bathrooms/ toilets.
- SWIMMING POOL & SPA:**
- Heating system: Solar only
  - Install timer for the pool pump
- ALTERNATIVE ENERGY:**
- Photovoltaic system (min 3.5 peak kilowatts)
- OTHER:**
- Induction cooktop & electric oven in the kitchen
  - Fixed outdoor clothes drying line
  - Fixed indoor or sheltered clothes drying line

ARCHITECT

**B**ARCHITECTS

t: 02 8970 5417  
e: studio@bjbarchitects.com.au  
a: 3.09/77 Dunning Ave  
Rosebery NSW 2018

BJB Architects Pty Ltd  
Nominated Architect:  
Barry Babikian NSW Reg No 8806

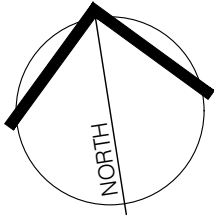

ISSUE	AMENDMENT	DATE
E	Development Application	13.10.2020
F	DA Amendment	12.04.2021
G	Amendment - LEC	10.05.2022
H	Amendment - LEC	24.05.2022

PROJECT

**75 COOLAWIN ROAD,  
NORTHBRIDGE**

NEW DWELLING

SITE PLAN & BASIX REQUIREMENTS


SCALE: 1:250 @ A3 DATE: 24.05.2022

ISSUE: H - Amendment - LEC

THIS DOCUMENT IS THE COPYRIGHT OF BJB ARCHITECTS. ALL INFORMATION ILLUSTRATED ON THIS DOCUMENT IS TO BE CHECKED AND VERIFIED ON SITE. IN THE EVENT OF DISCREPANCIES REFER TO BJB ARCHITECTS PRIOR TO COMMENCEMENT OF THE WORK. DO NOT SCALE DRAWINGS MANUALLY OR ELECTRONICALLY.

2020-031  
**A1001**



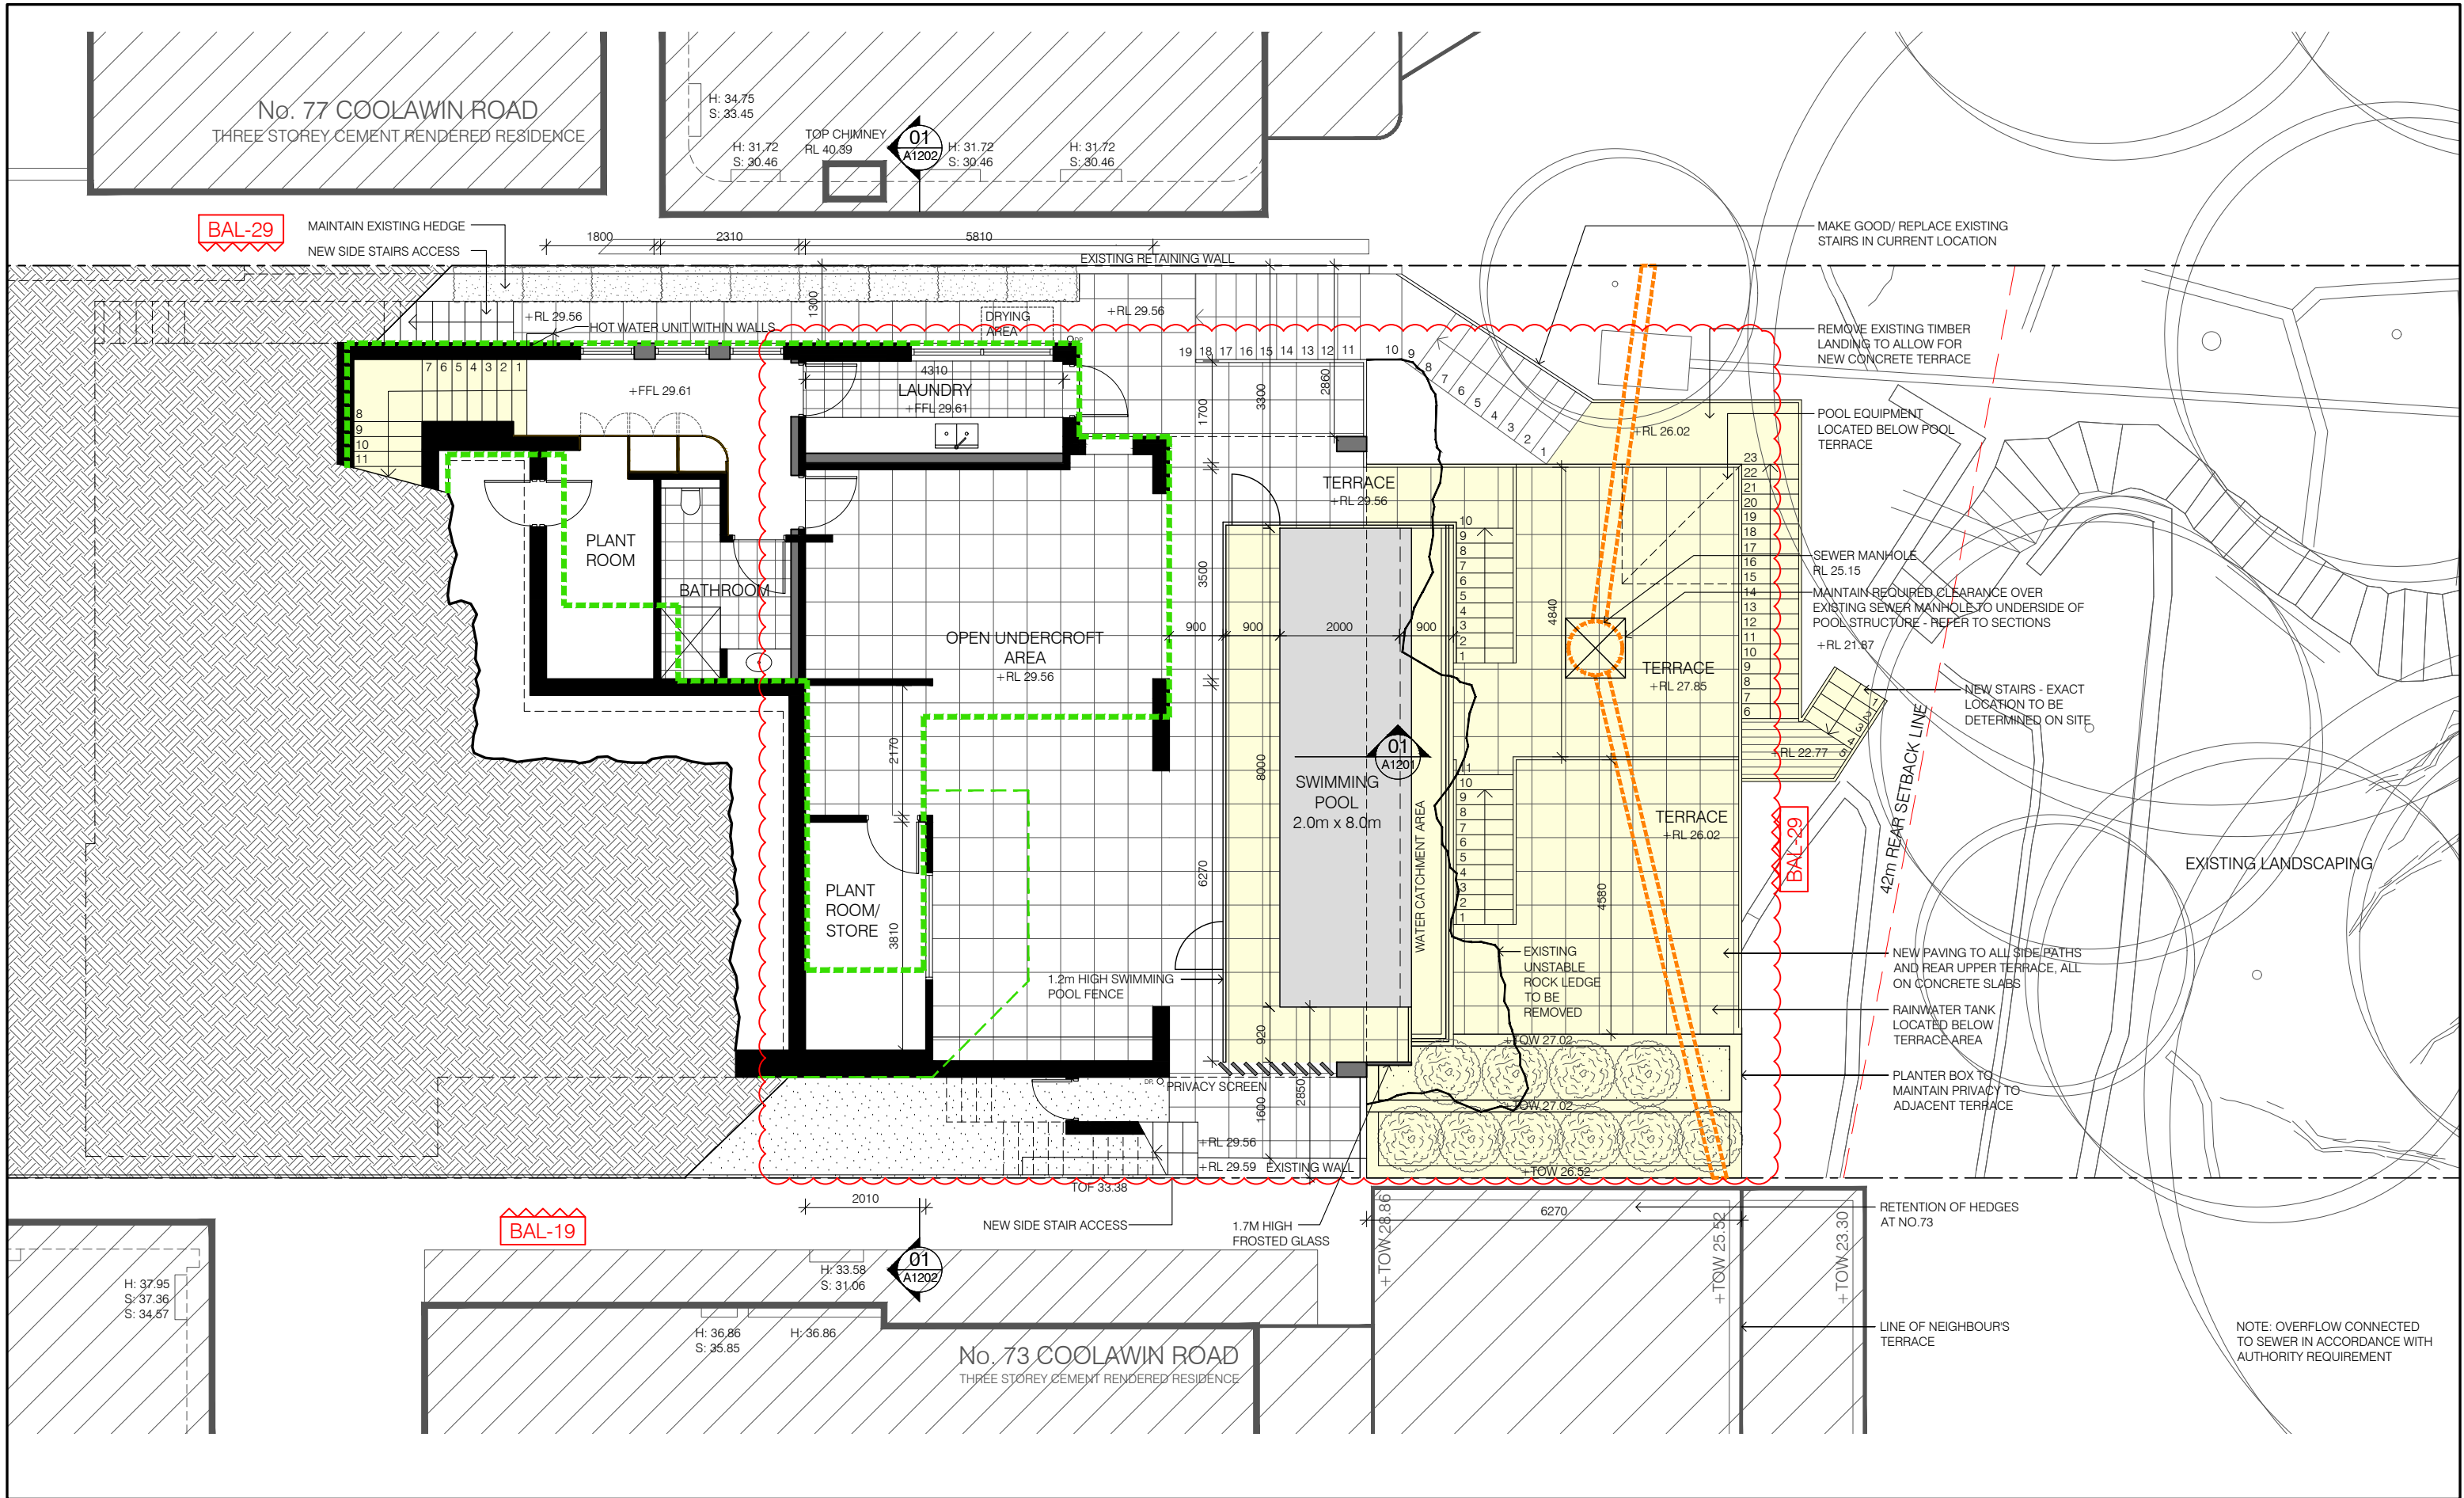

ARCHITECT

t: 02 8970 5417  
e: studio@bjbarchitects.com.au  
a: 3.09/77 Dunning Ave  
Rosebery NSW 2018

BJB Architects Pty Ltd  
Nominated Architect:  
Barry Babikian NSW Reg No 8806

**LEGEND**

- EXISTING STRUCTURE
- NEW STRUCTURE
- PROPOSED AREA OF WORKS
- PREVIOUS DA SUBMISSION

ISSUE	AMENDMENT	DATE
E	Development Application	13.10.2020
F	DA Amendment	12.04.2021
G	Amendment - LEC	10.05.2022
H	Amendment - LEC	24.05.2022

PROJECT

**75 COOLAWIN ROAD,  
NORTHBRIDGE**

NEW DWELLING

LOWER GROUND FLOOR PLAN & REAR TERRACE


SCALE: 1:100 @ A3      DATE: 24.05.2022

ISSUE: H - Amendment - LEC


THIS DOCUMENT IS THE COPYRIGHT OF BJB ARCHITECTS. ALL INFORMATION ILLUSTRATED ON THIS DOCUMENT IS TO BE CHECKED AND VERIFIED ON SITE. IN THE EVENT OF DISCREPANCIES REFER TO BJB ARCHITECTS PRIOR TO COMMENCEMENT OF THE WORK. DO NOT SCALE DRAWINGS MANUALLY OR ELECTRONICALLY.

2020-031

**A1101**

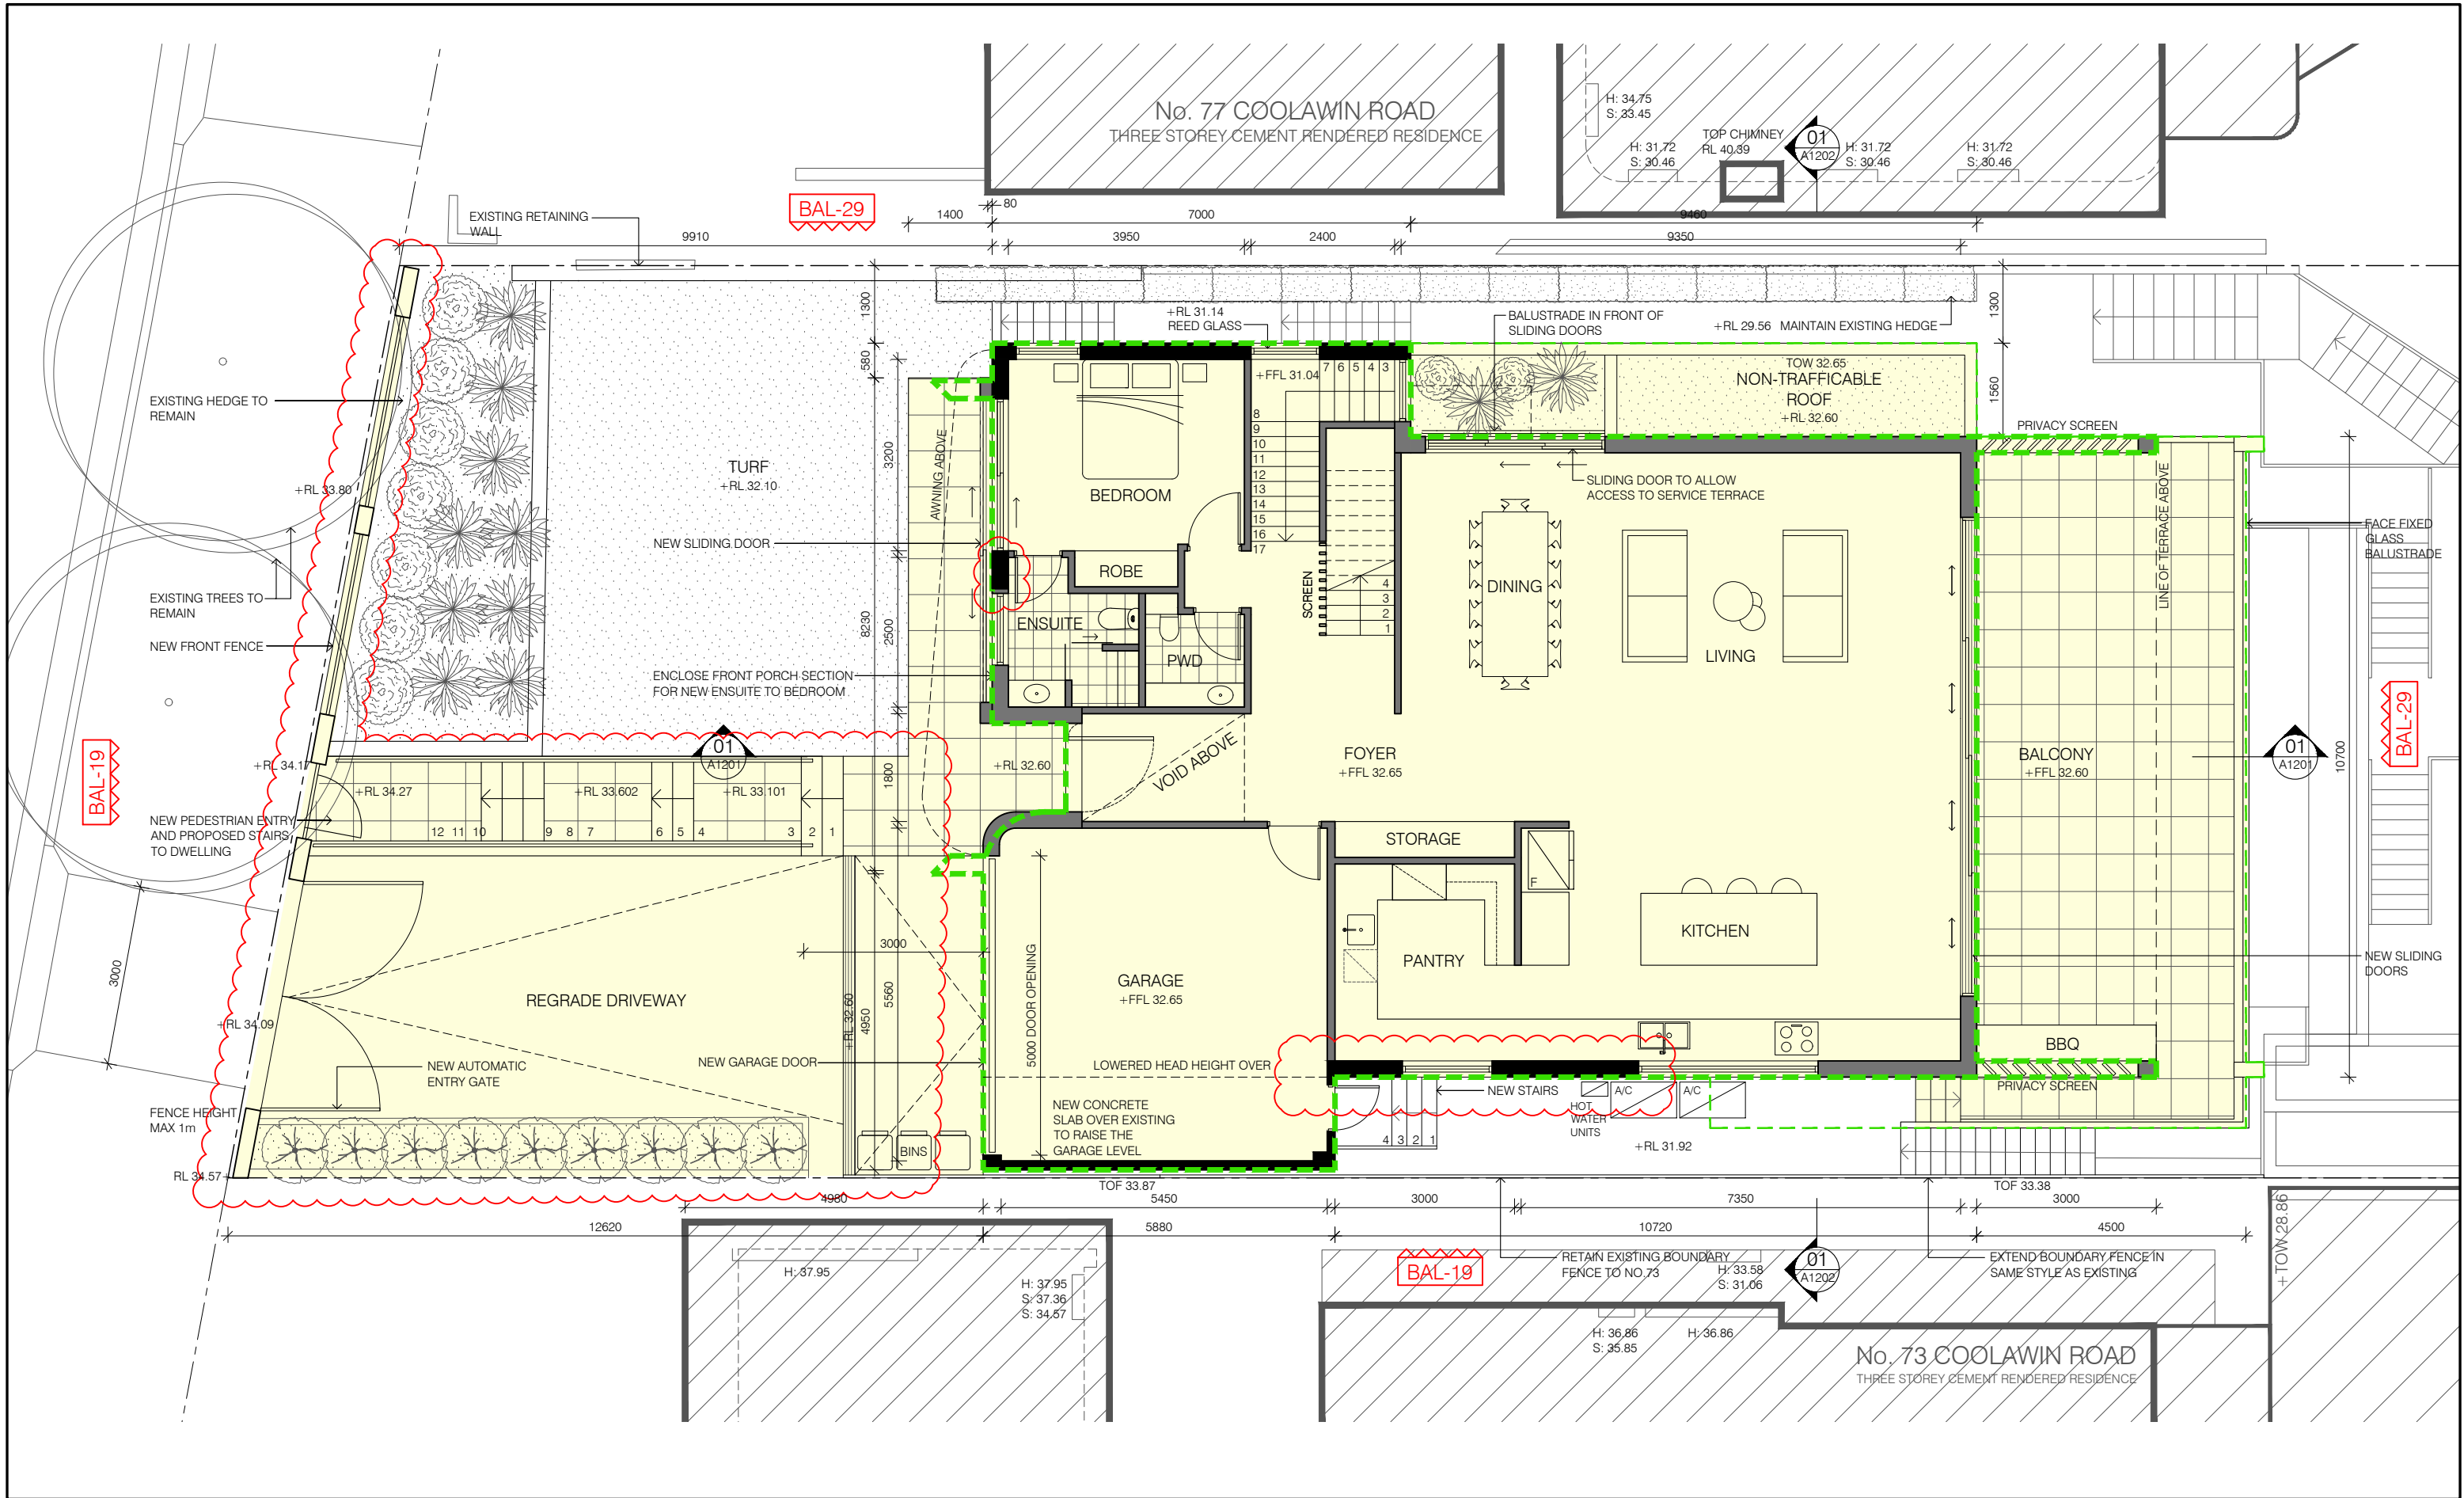

ARCHITECT

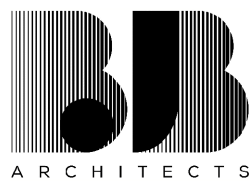


t: 02 8970 5417  
e: studio@bjbarchitects.com.au  
a: 3.09/77 Dunning Ave  
Rosebery NSW 2018

BJB Architects Pty Ltd  
Nominated Architect:  
Barry Babikian NSW Reg No 8806

LEGEND

- EXISTING STRUCTURE
- NEW STRUCTURE
- PROPOSED AREA OF WORKS
- PREVIOUS DA SUBMISSION

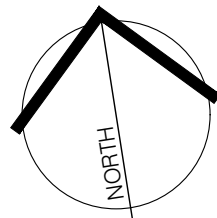

ISSUE	AMENDMENT	DATE
E	Development Application	13.10.2020
F	DA Amendment	12.04.2021
G	Amendment - LEC	10.05.2022
H	Amendment - LEC	24.05.2022

PROJECT

75 COOLAWIN ROAD,  
NORTHBRIDGE  
NEW DWELLING

GROUND FLOOR PLAN


SCALE: 1:100 @ A3 DATE: 24.05.2022

ISSUE: H - Amendment - LEC


THIS DOCUMENT IS THE COPYRIGHT OF BJB ARCHITECTS.  
ALL INFORMATION ILLUSTRATED ON THIS DOCUMENT IS  
TO BE CHECKED AND VERIFIED ON SITE.  
IN THE EVENT OF DISCREPANCIES REFER TO BJB  
ARCHITECTS PRIOR TO COMMENCEMENT OF THE WORK.  
DO NOT SCALE DRAWINGS MANUALLY OR  
ELECTRONICALLY.

2020-031  
A1102



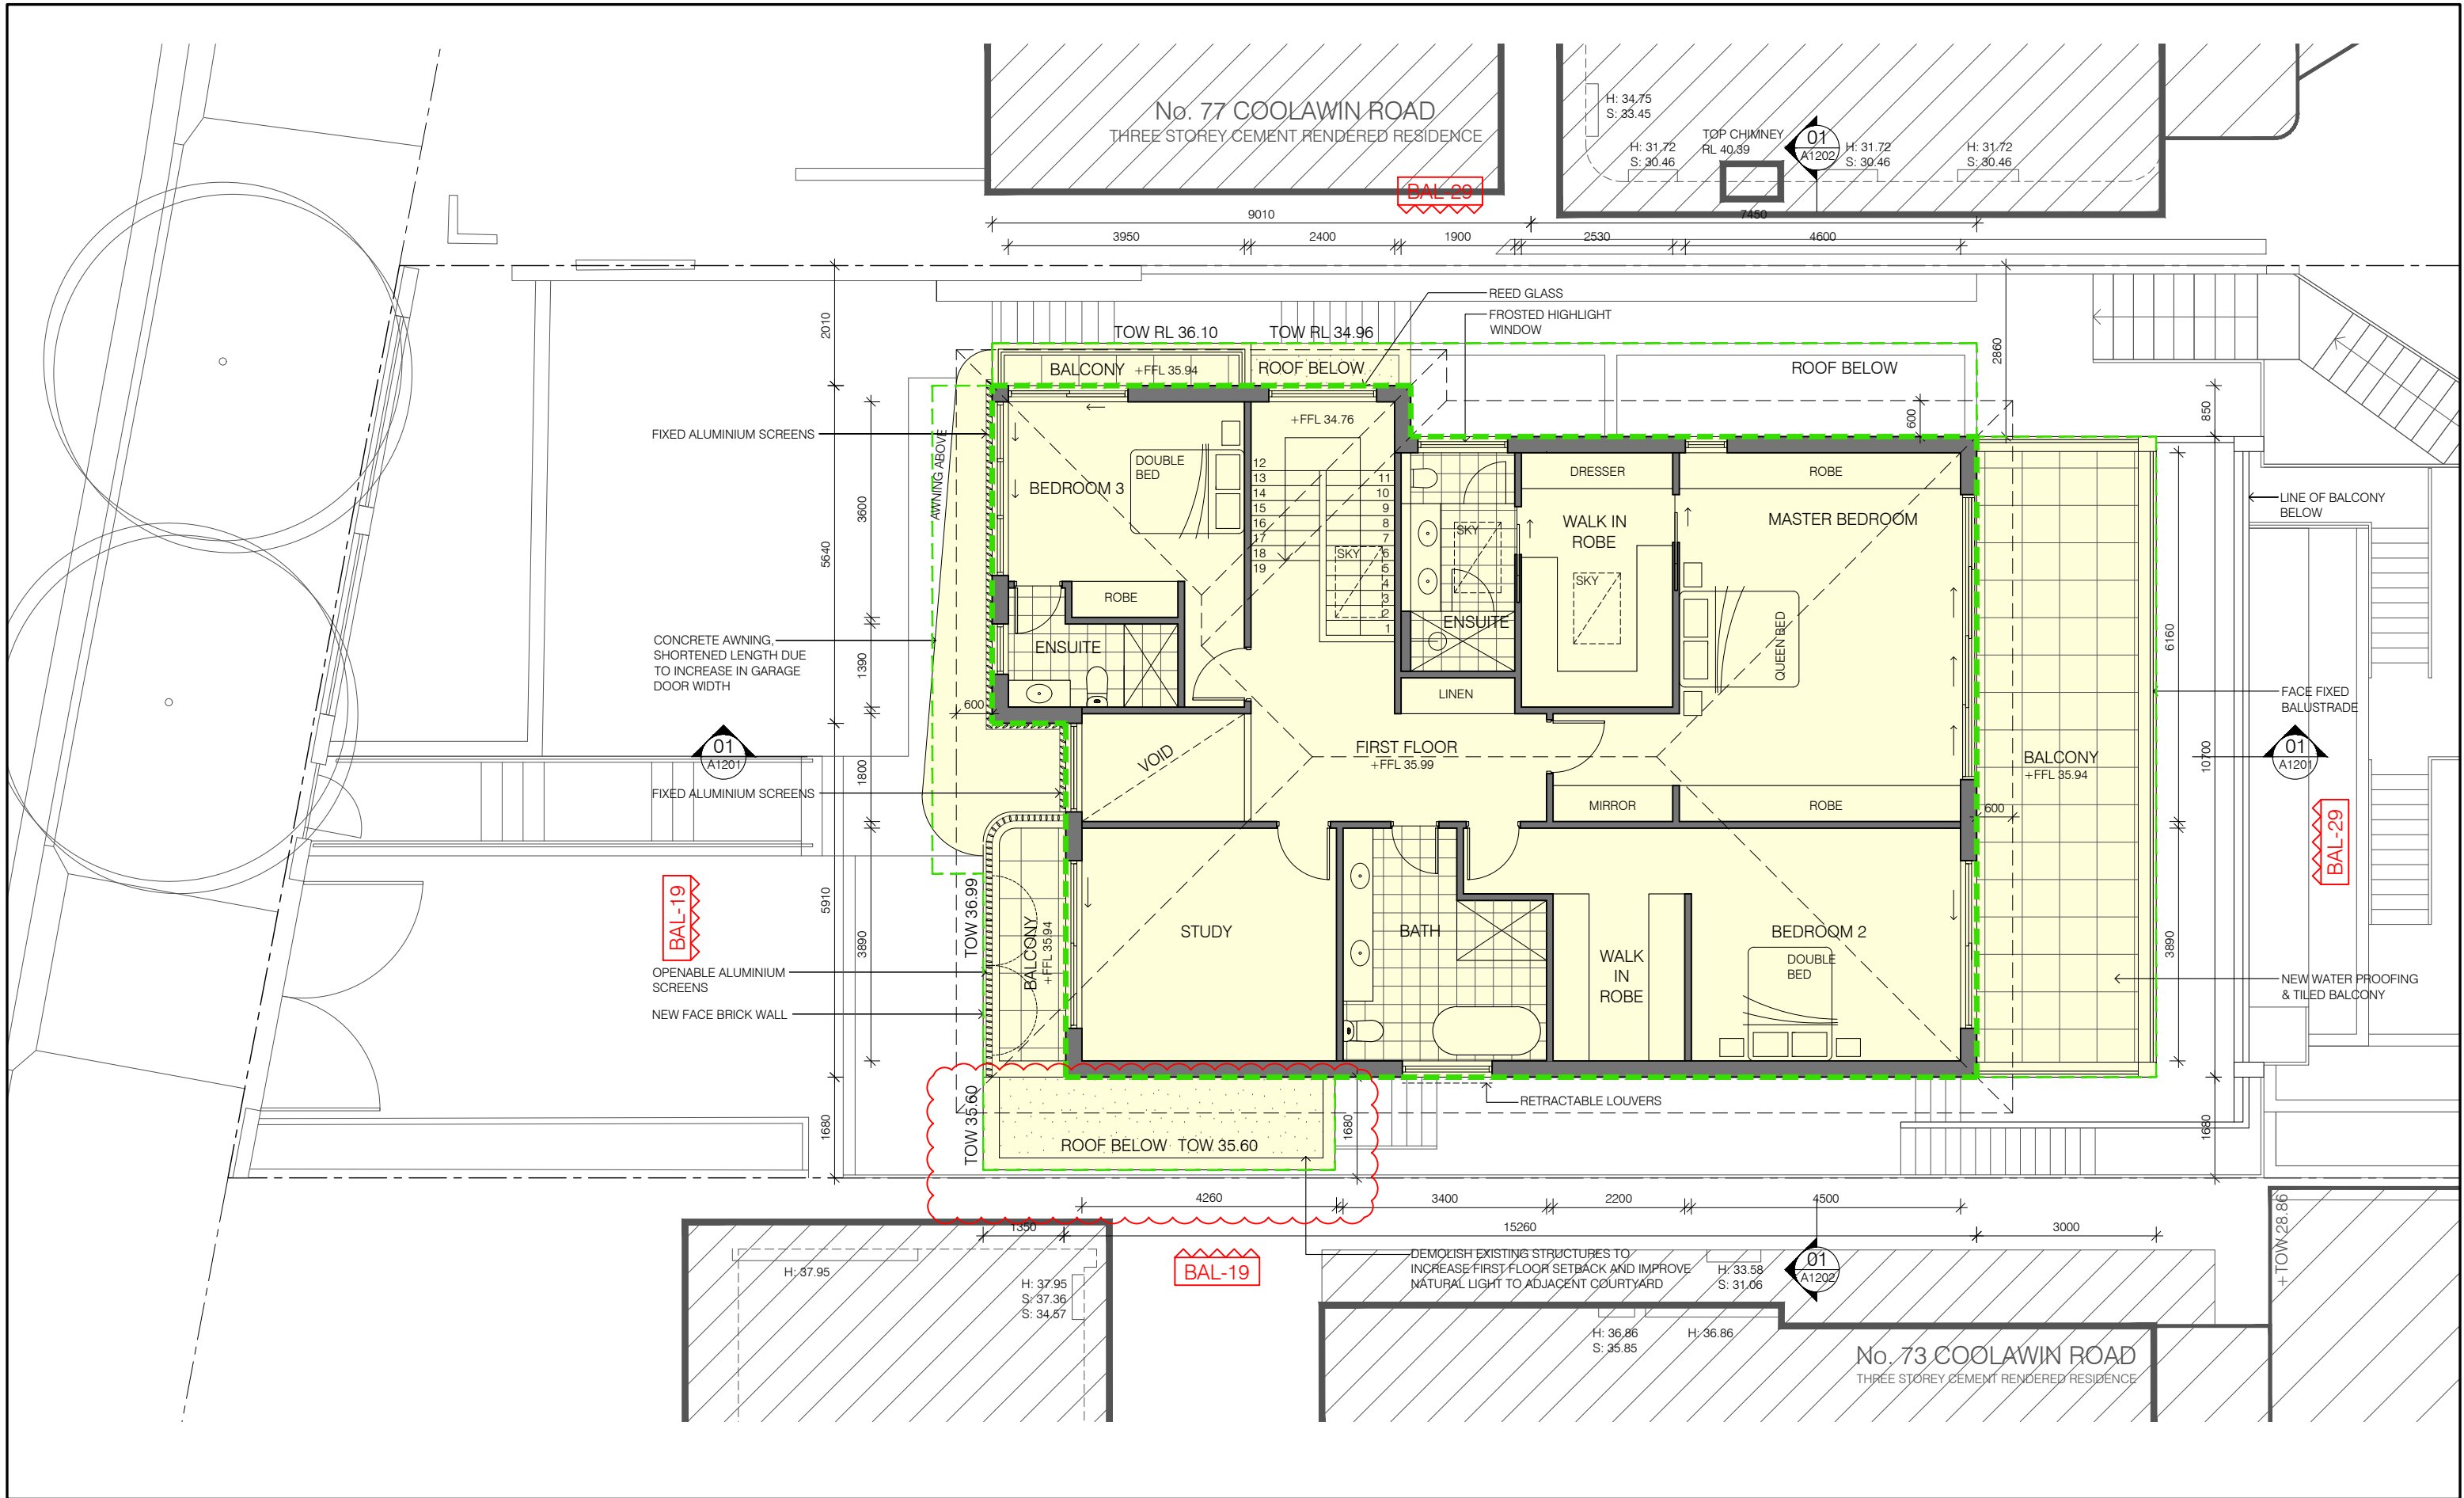

ARCHITECT

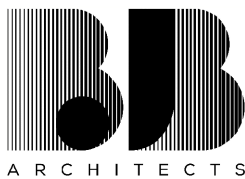


t: 02 8970 5417  
e: studio@bjbarchitects.com.au  
a: 3.09/77 Dunning Ave  
Rosebery NSW 2018

BJB Architects Pty Ltd  
Nominated Architect:  
Barry Babikian NSW Reg No 8806

LEGEND

- EXISTING STRUCTURE
- NEW STRUCTURE
- PROPOSED AREA OF WORKS
- PREVIOUS DA SUBMISSION

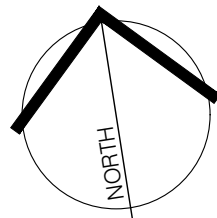

ISSUE	AMENDMENT	DATE
E	Development Application	13.10.2020
F	DA Amendment	12.04.2021
G	Amendment - LEC	10.05.2022
H	Amendment - LEC	24.05.2022

PROJECT

75 COOLAWIN ROAD,  
NORTHBRIDGE  
NEW DWELLING

FIRST FLOOR PLAN


SCALE: 1:100 @ A3 DATE: 24.05.2022

ISSUE: H - Amendment - LEC


THIS DOCUMENT IS THE COPYRIGHT OF BJB ARCHITECTS.  
ALL INFORMATION ILLUSTRATED ON THIS DOCUMENT IS  
TO BE CHECKED AND VERIFIED ON SITE.  
IN THE EVENT OF DISCREPANCIES REFER TO BJB  
ARCHITECTS PRIOR TO COMMENCEMENT OF THE WORK.  
DO NOT SCALE DRAWINGS MANUALLY OR  
ELECTRONICALLY.

2020-031

A1103

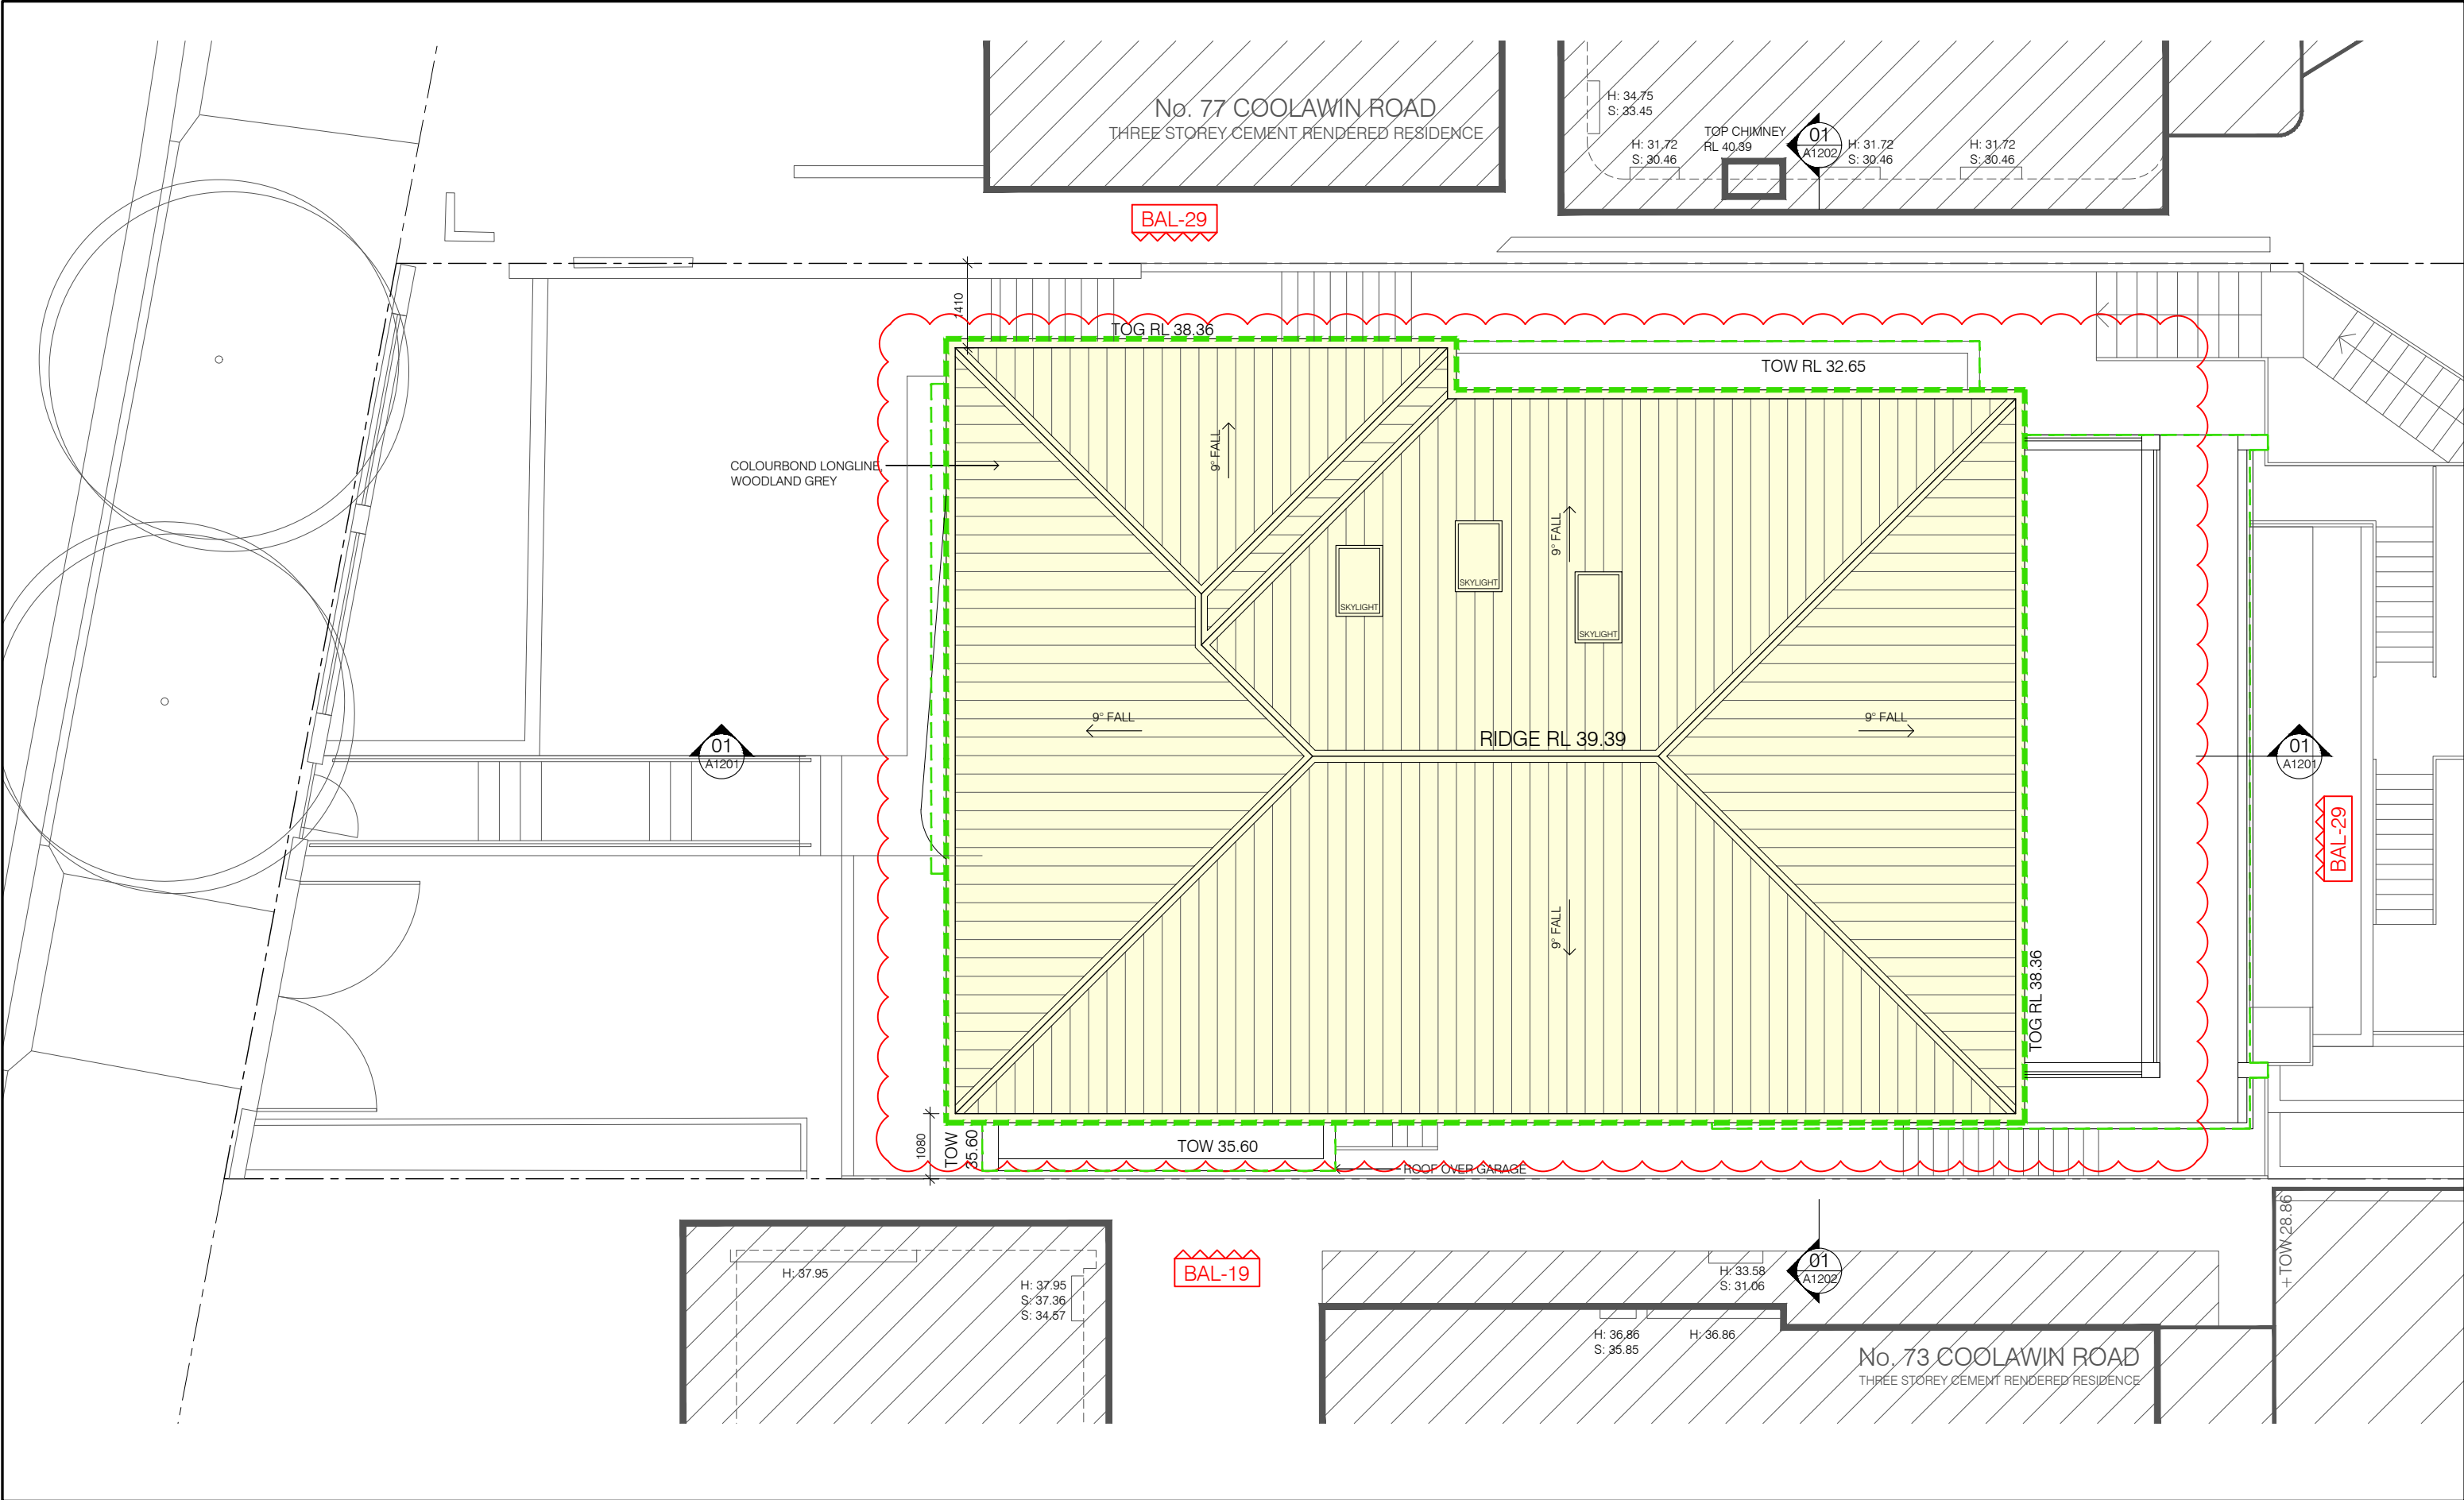

ARCHITECT

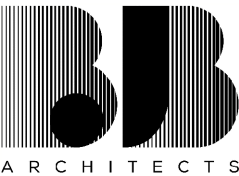


t: 02 8970 5417  
e: studio@bjbarchitects.com.au  
a: 3.09/77 Dunning Ave  
Rosebery NSW 2018

BJB Architects Pty Ltd  
Nominated Architect:  
Barry Babikian NSW Reg No 8806

LEGEND

- EXISTING STRUCTURE
- NEW STRUCTURE
- PROPOSED AREA OF WORKS
- PREVIOUS DA SUBMISSION

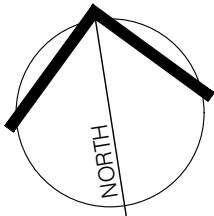

ISSUE	AMENDMENT	DATE
E	Development Application	13.10.2020
F	DA Amendment	12.04.2021
G	Amendment - LEC	10.05.2022
H	Amendment - LEC	24.05.2022

PROJECT

75 COOLAWIN ROAD,  
NORTHBRIDGE  
NEW DWELLING

ROOF PLAN

SCALE: 1:100 @ A3 DATE: 24.05.2022


ISSUE: H - Amendment - LEC


THIS DOCUMENT IS THE COPYRIGHT OF BJB ARCHITECTS.  
ALL INFORMATION ILLUSTRATED ON THIS DOCUMENT IS  
TO BE CHECKED AND VERIFIED ON SITE.  
IN THE EVENT OF DISCREPANCIES REFER TO BJB  
ARCHITECTS PRIOR TO COMMENCEMENT OF THE WORK.  
DO NOT SCALE DRAWINGS MANUALLY OR  
ELECTRONICALLY.

2020-031

A1104




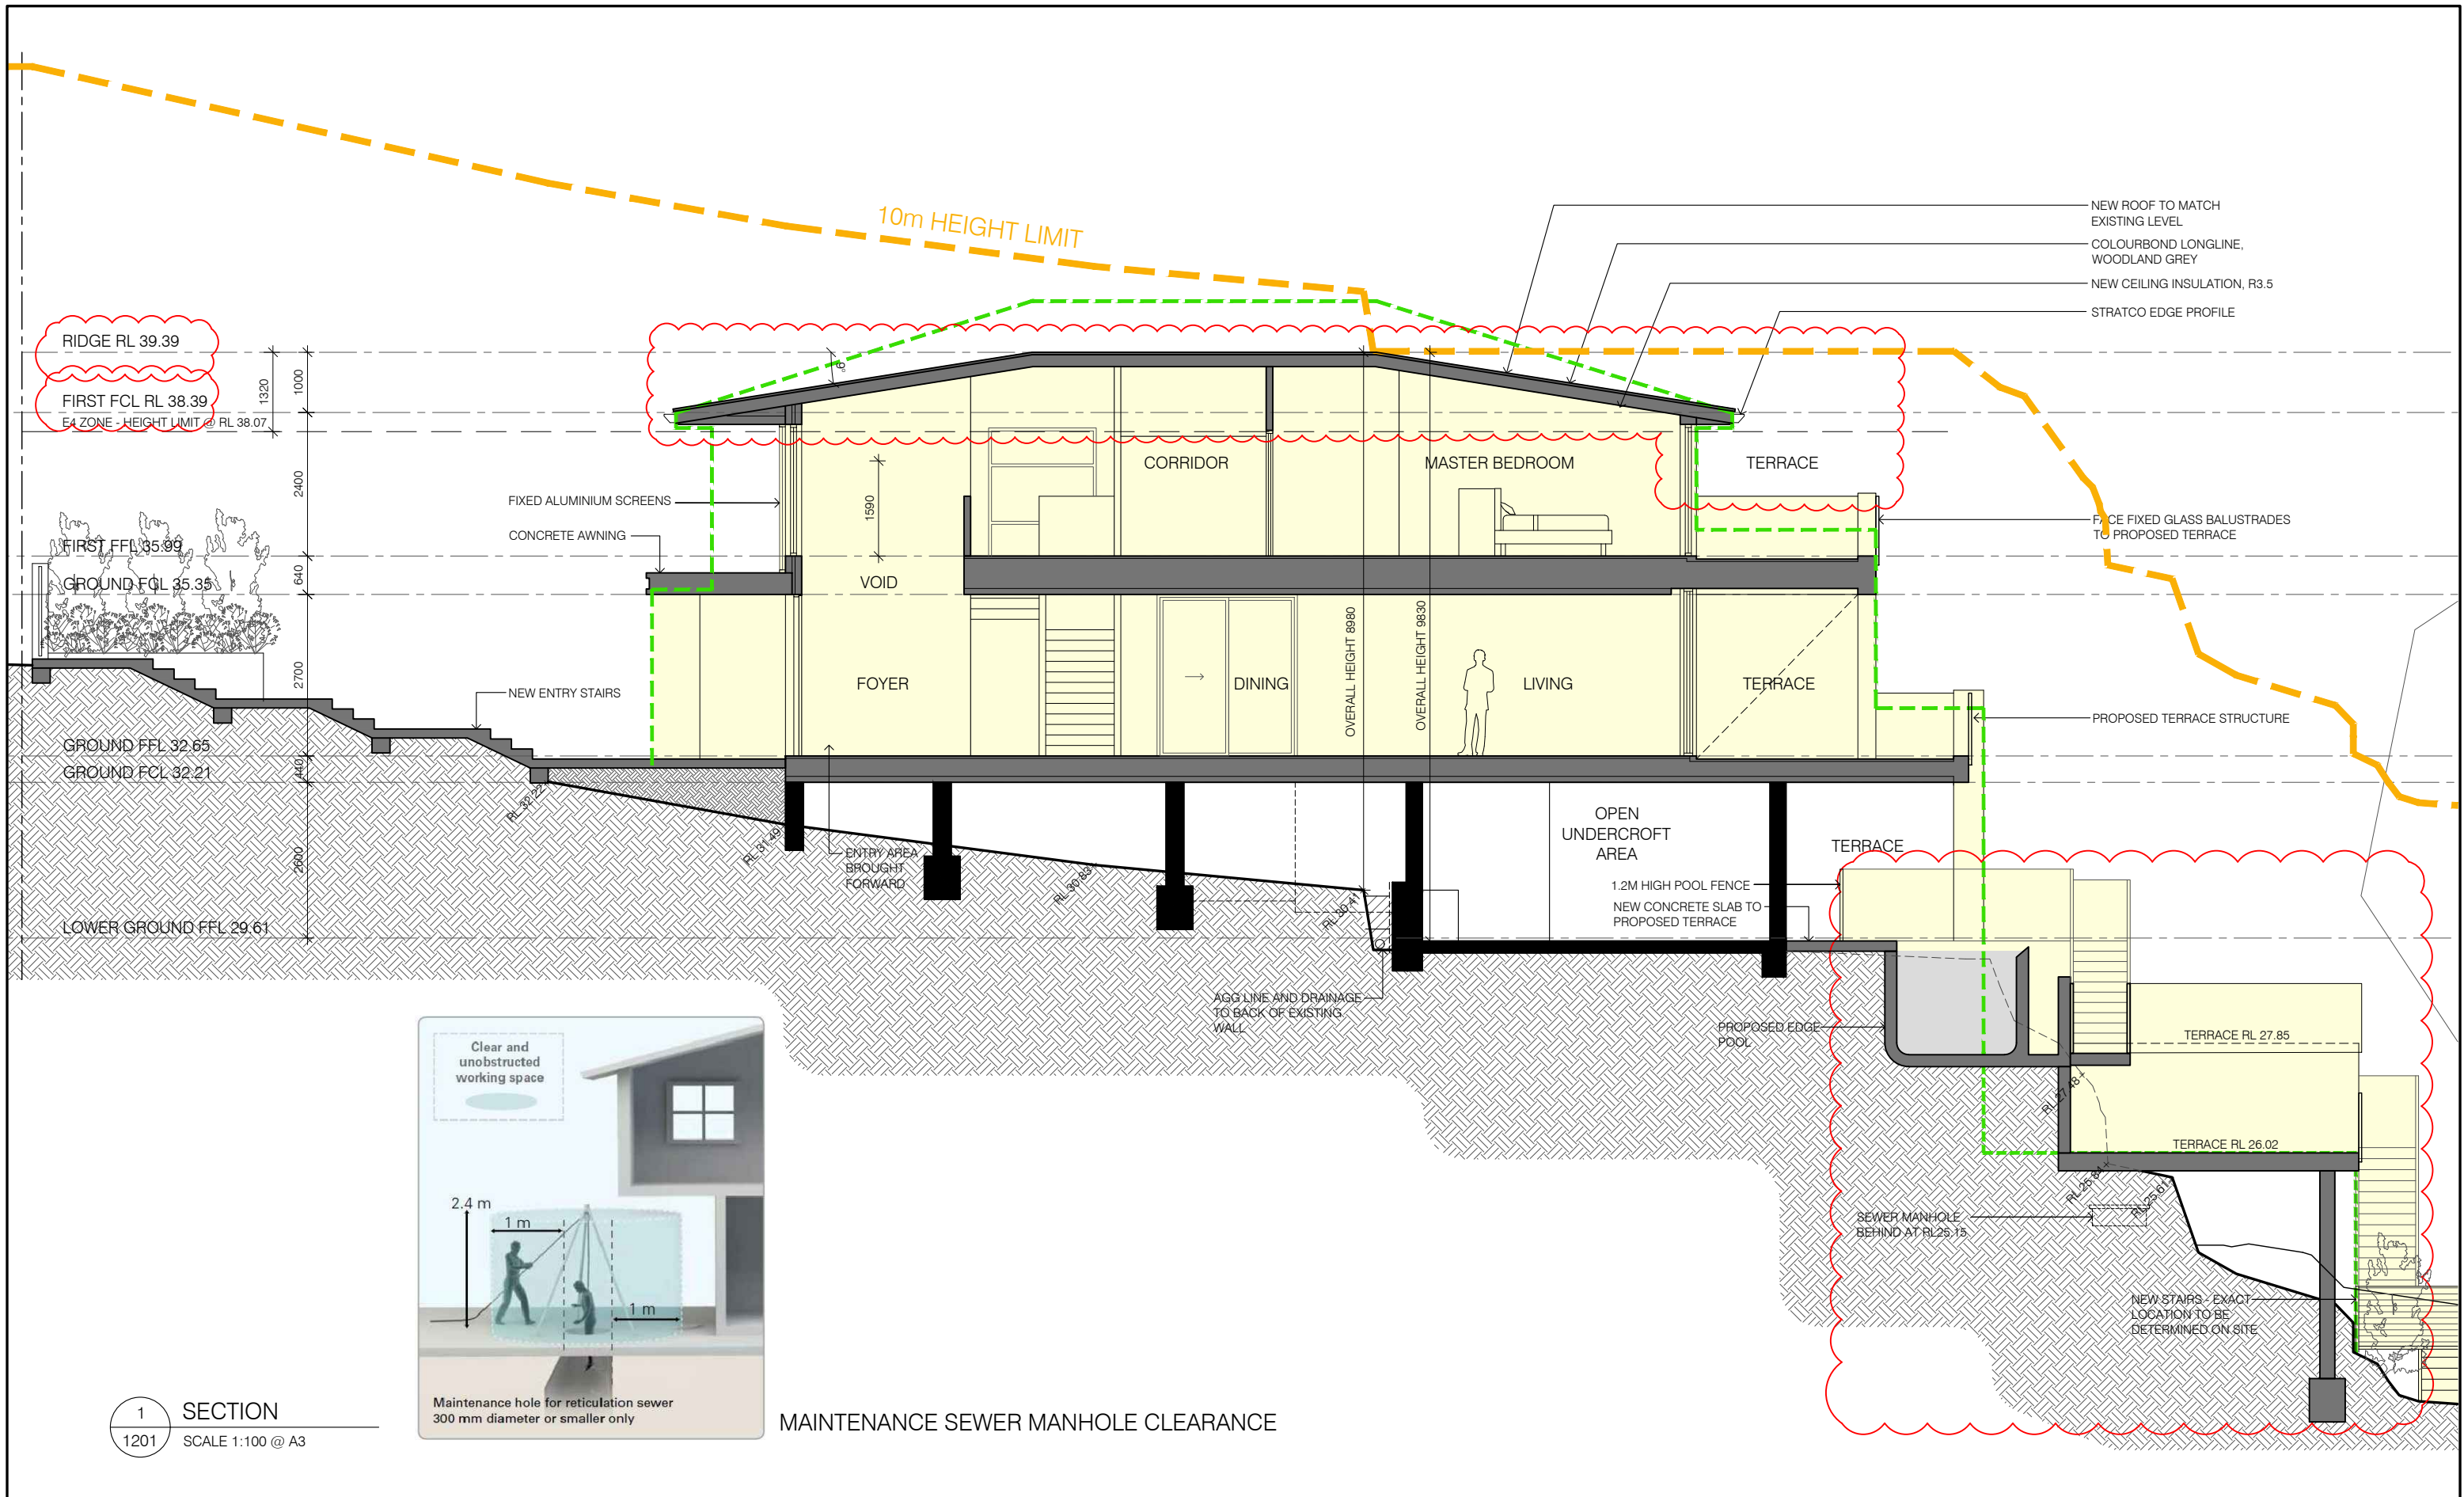

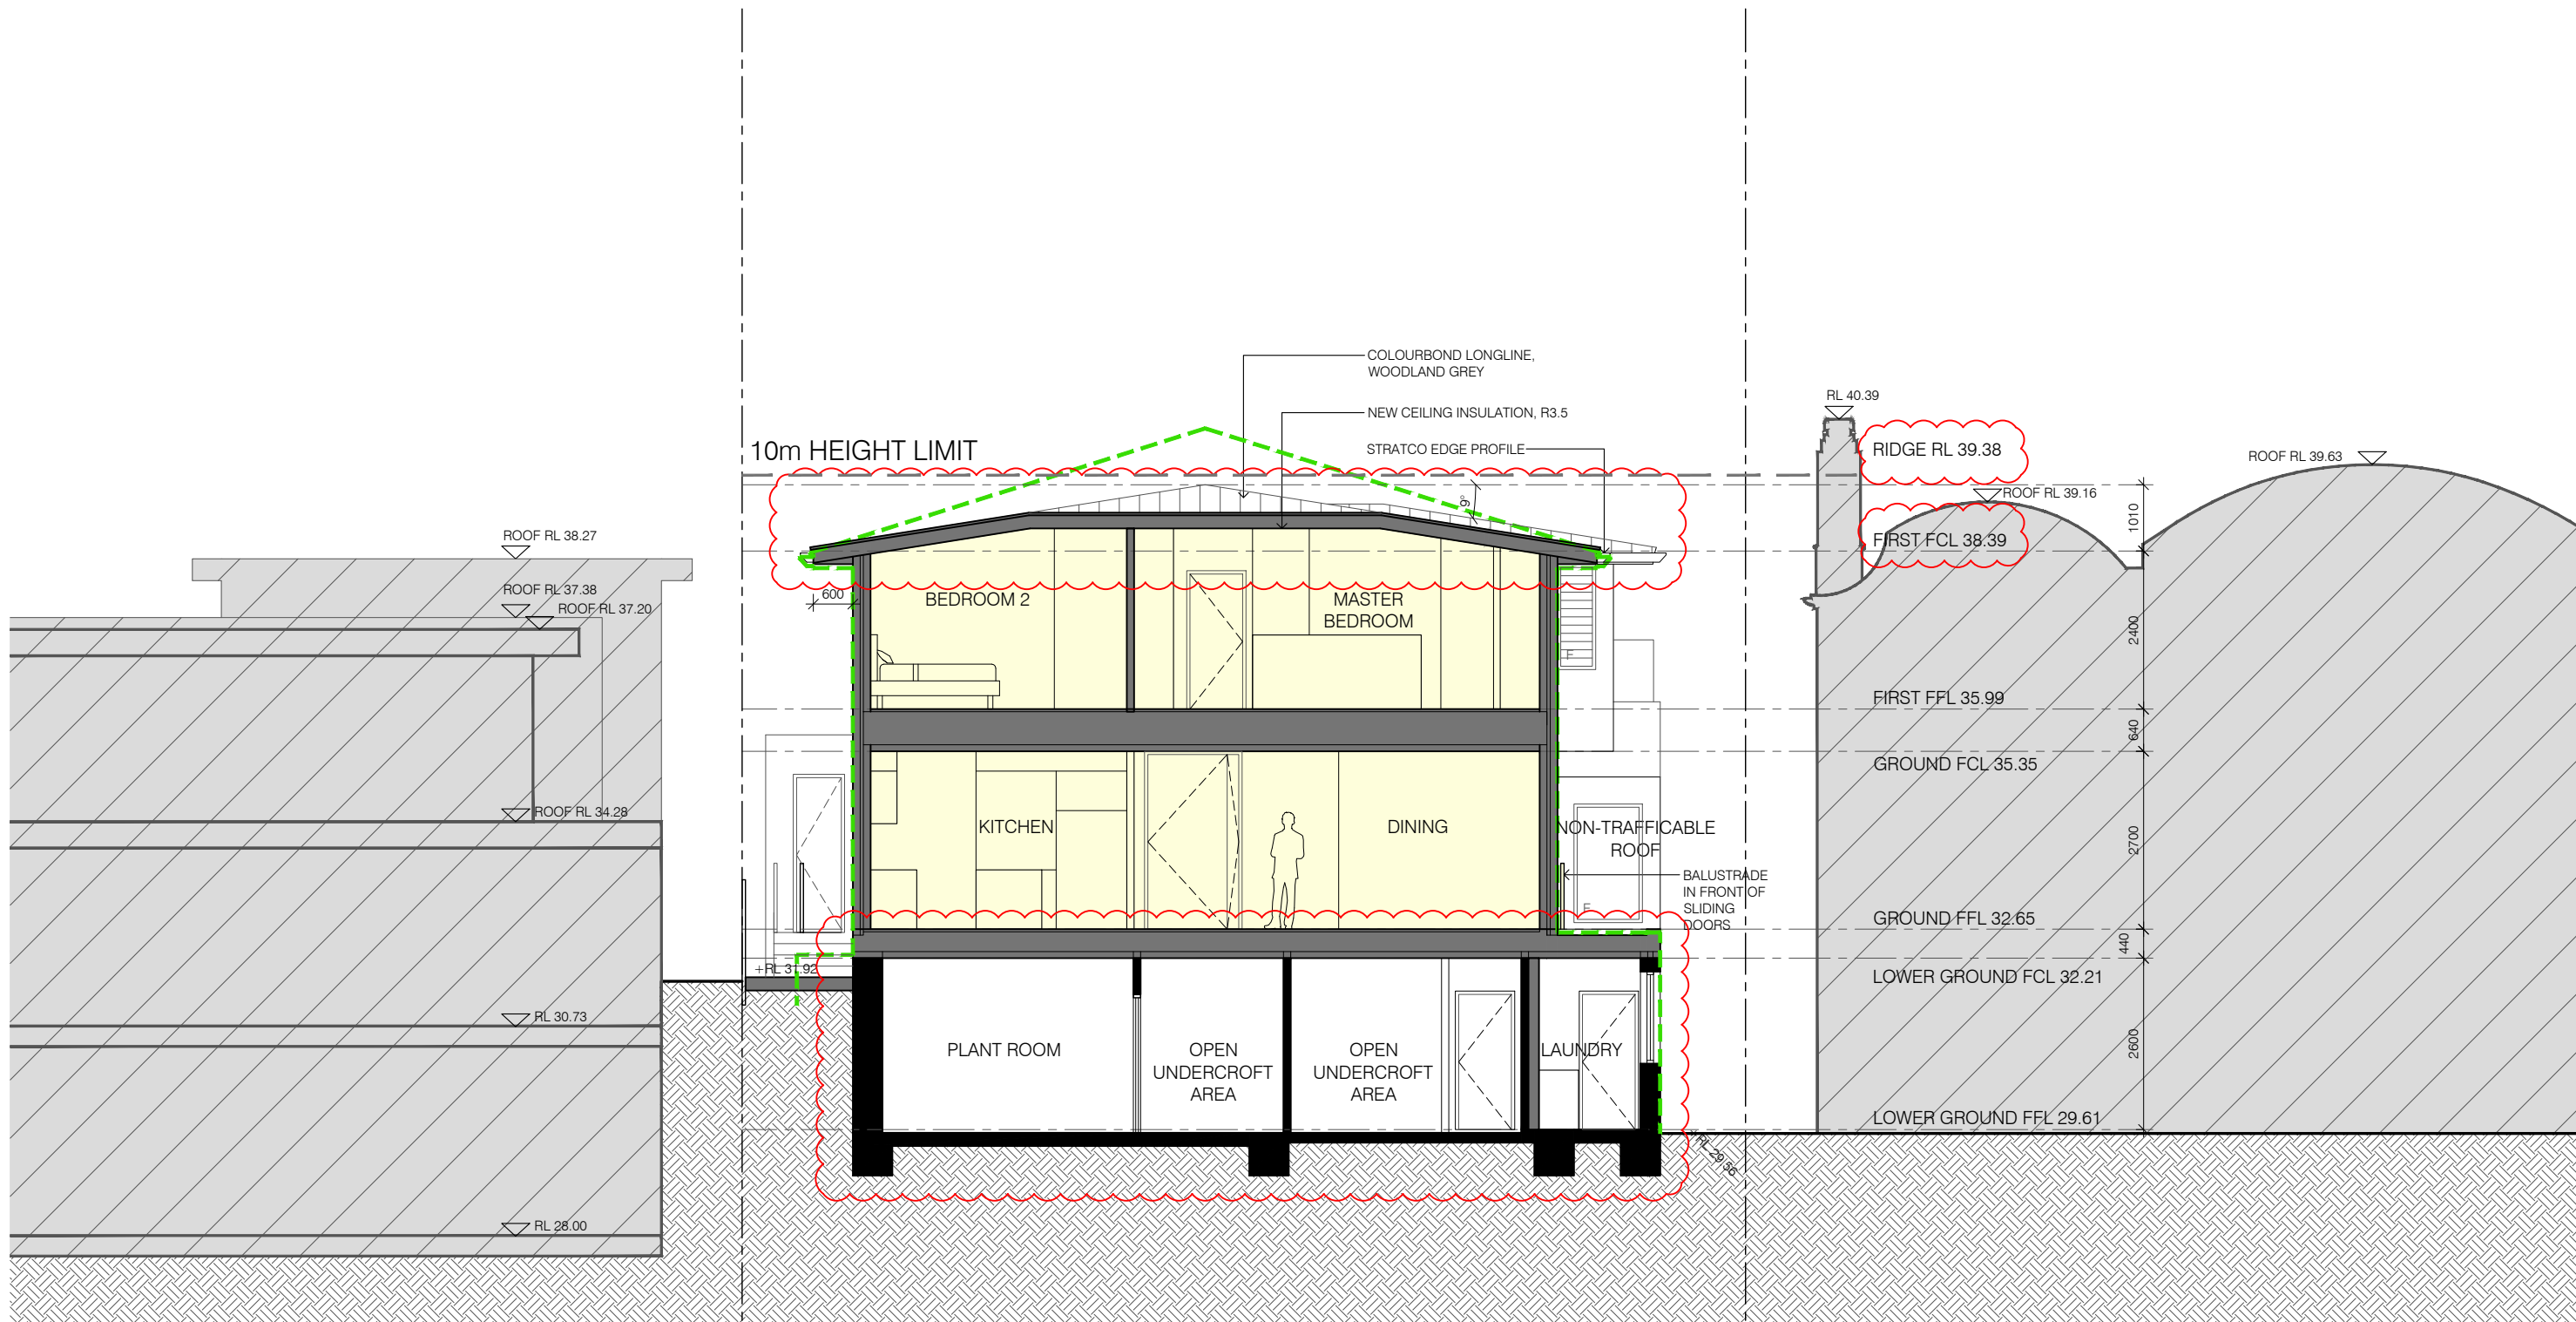

1 SECTION  
1202 SCALE 1:100 @ A3

ARCHITECT

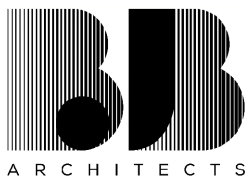

t: 02 8970 5417  
e: studio@bjbarchitects.com.au  
a: 3.09/77 Dunning Ave  
Rosebery NSW 2018

BJB Architects Pty Ltd  
Nominated Architect:  
Barry Babikian NSW Reg No 8806

LEGEND

- EXISTING STRUCTURE
- NEW STRUCTURE
- PROPOSED AREA OF WORKS
- PREVIOUS DA SUBMISSION

ISSUE	AMENDMENT	DATE
E	Development Application	13.10.2020
F	DA Amendment	12.04.2021
G	Amendment - LEC	10.05.2022
H	Amendment - LEC	24.05.2022

PROJECT

75 COOLAWIN ROAD,  
NORTHBRIDGE  
NEW DWELLING

SECTIONS

SCALE: 1:100 @ A3 DATE: 24.05.2022


ISSUE: H - Amendment - LEC

THIS DOCUMENT IS THE COPYRIGHT OF BJB ARCHITECTS.  
ALL INFORMATION ILLUSTRATED ON THIS DOCUMENT IS  
TO BE CHECKED AND VERIFIED ON SITE.  
IN THE EVENT OF DISCREPANCIES REFER TO BJB  
ARCHITECTS PRIOR TO COMMENCEMENT OF THE WORK.  
DO NOT SCALE DRAWINGS MANUALLY OR  
ELECTRONICALLY.


2020-031

A1202



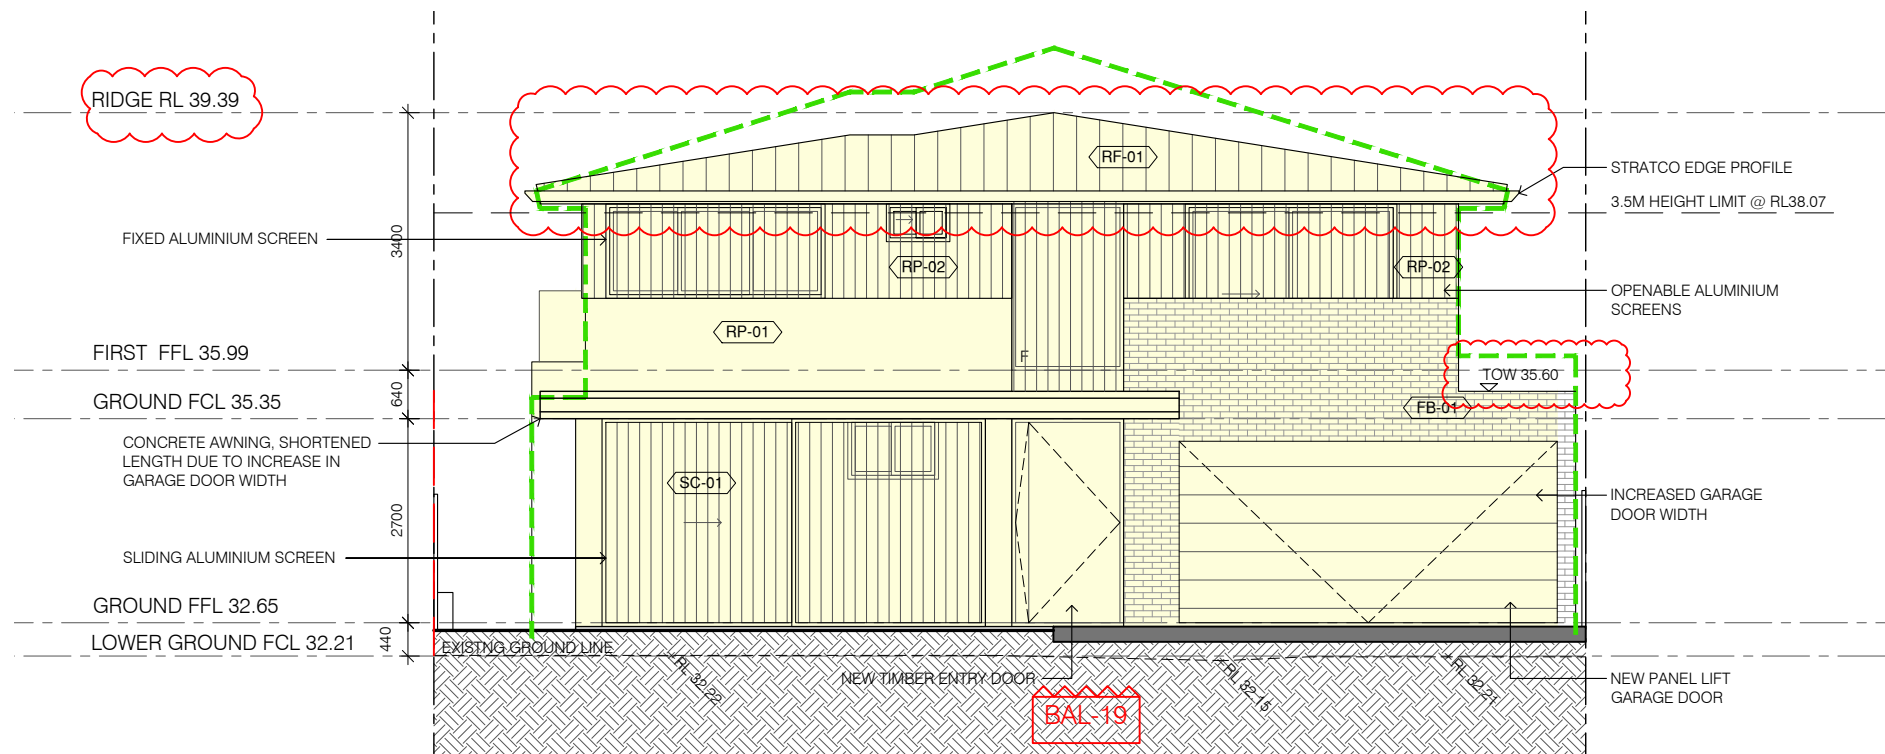

2 WEST ELEVATION AT ENTRY LEVEL  
1301 SCALE 1:100 @ A3

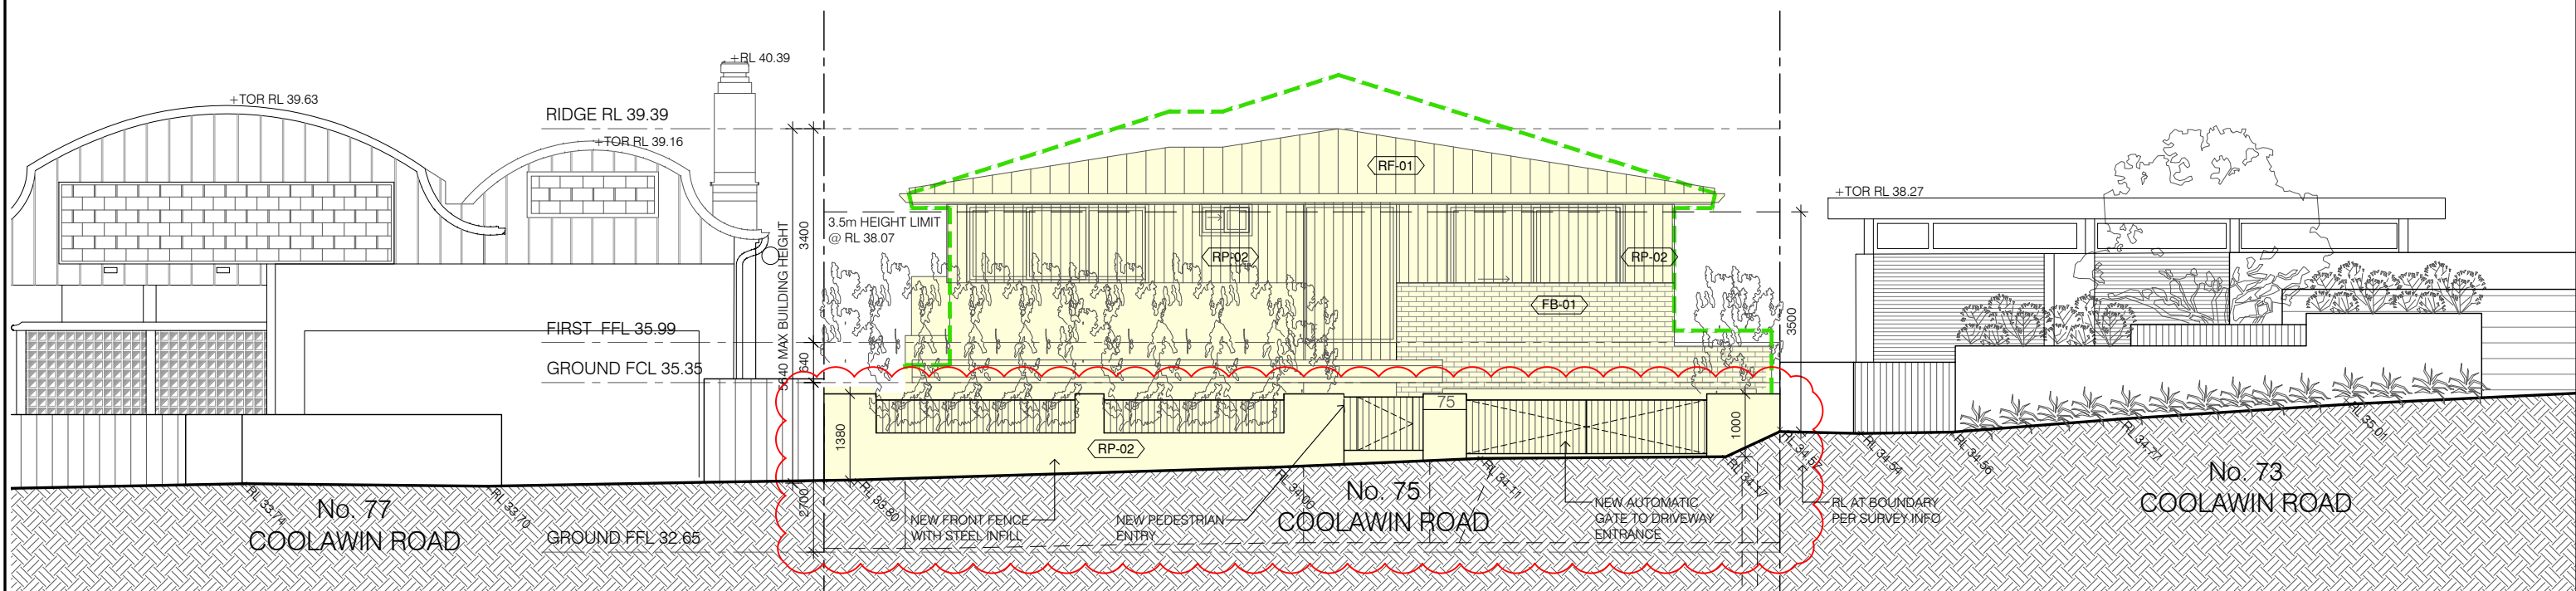

1 STREET ELEVATION  
1301 SCALE 1:100 @ A3

ARCHITECT



t: 02 8970 5417  
e: studio@bjbarchitects.com.au  
a: 3.09/77 Dunning Ave  
Rosebery NSW 2018  
BJB Architects Pty Ltd  
Nominated Architect:  
Barry Babikian NSW Reg No 8806

LEGEND

- EXISTING STRUCTURE
- NEW STRUCTURE
- PROPOSED AREA OF WORKS
- PREVIOUS DA SUBMISSION

EXTERNAL FINISHES LEGEND

- RP-01 RENDER & PAINT DULUX MCGINLEY
- RP-02 RENDER & PAINT DULUX RAKU
- FB-01 PGH BRICKS - PEWTER METALLIC
- RF-01 COLORBOND LONGLINE 305 ROOFING, WOODLAND GREY
- GL-01 GLASS BALUSTRADE
- SC-01 TIMBER SCREEN

ISSUE	AMENDMENT	DATE
E	Development Application	13.10.2020
F	DA Amendment	12.04.2021
G	Amendment - LEC	10.05.2022
H	Amendment - LEC	24.05.2022

PROJECT

75 COOLAWIN ROAD,  
NORTHBRIDGE  
NEW DWELLING


ELEVATIONS

SCALE: 1:100 @ A3 DATE: 24.05.2022

ISSUE: H - Amendment - LEC

THIS DOCUMENT IS THE COPYRIGHT OF BJB ARCHITECTS. ALL INFORMATION ILLUSTRATED ON THIS DOCUMENT IS TO BE CHECKED AND VERIFIED ON SITE. IN THE EVENT OF DISCREPANCIES REFER TO BJB ARCHITECTS PRIOR TO COMMENCEMENT OF THE WORK. DO NOT SCALE DRAWINGS MANUALLY OR ELECTRONICALLY.

2020-031  
A1301

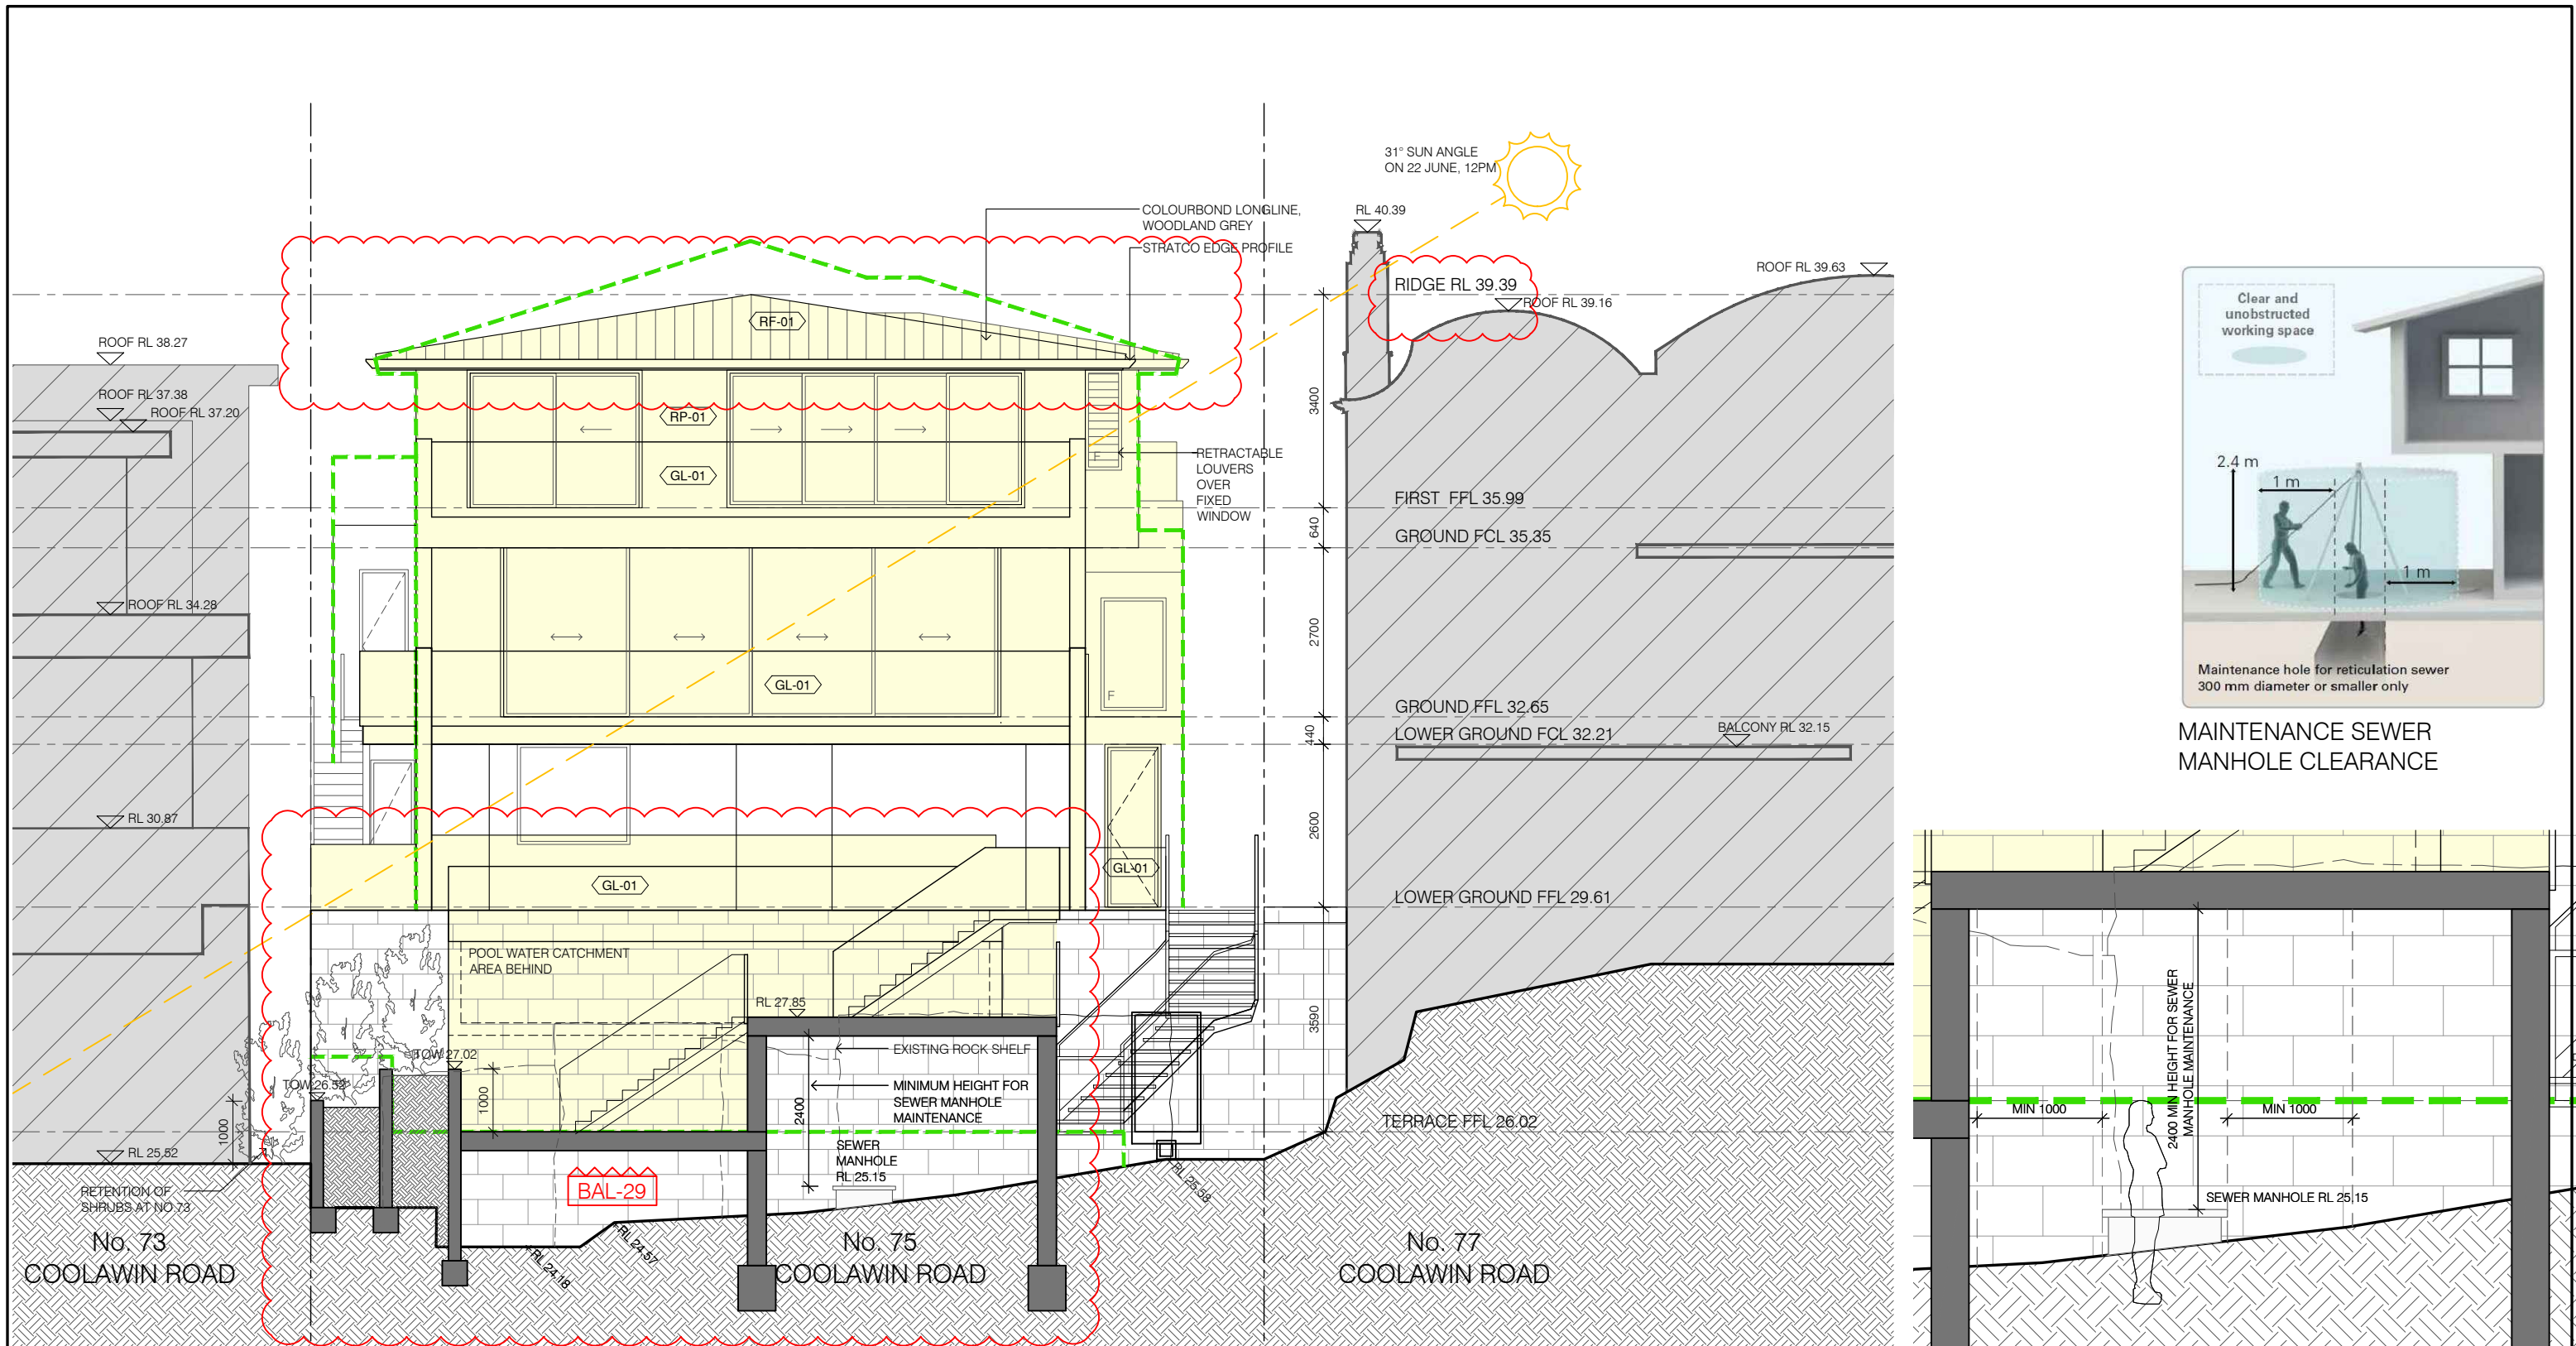

1 EAST ELEVATION AT REAR EXIT LEVEL  
1302 SCALE 1:100 @ A3

2 SEWER MANHOLE MAINTENANCE REQUIREMENTS  
1302 SCALE 1:100 @ A3

ARCHITECT



t: 02 8970 5417  
e: studio@bjbarchitects.com.au  
a: 3.09/77 Dunning Ave  
Rosebery NSW 2018

BJB Architects Pty Ltd  
Nominated Architect:  
Barry Babikian NSW Reg No 8806

LEGEND

- EXISTING STRUCTURE
- NEW STRUCTURE
- PROPOSED AREA OF WORKS
- PREVIOUS DA SUBMISSION

EXTERNAL FINISHES LEGEND

- RP-01 RENDER & PAINT DULUX MCGINLEY
- RP-02 RENDER & PAINT DULUX RAKU
- FB-01 PGH BRICKS - PEWTER METALLIC
- RF-01 COLOURBOND LONGLINE 305 ROOFING, WOODLAND GREY
- GL-01 GLASS BALUSTRADE
- SC-01 TIMBER SCREEN

ISSUE	AMENDMENT	DATE
E	Development Application	13.10.2020
F	DA Amendment	12.04.2021
G	Amendment - LEC	10.05.2022
H	Amendment - LEC	24.05.2022

PROJECT

75 COOLAWIN ROAD,  
NORTHBRIDGE  
NEW DWELLING

ELEVATIONS


SCALE: 1:100 @ A3 DATE: 24.05.2022

ISSUE: H - Amendment - LEC

THIS DOCUMENT IS THE COPYRIGHT OF BJB ARCHITECTS. ALL INFORMATION ILLUSTRATED ON THIS DOCUMENT IS TO BE CHECKED AND VERIFIED ON SITE. IN THE EVENT OF DISCREPANCIES REFER TO BJB ARCHITECTS PRIOR TO COMMENCEMENT OF THE WORK. DO NOT SCALE DRAWINGS MANUALLY OR ELECTRONICALLY.


2020-031  
A1302



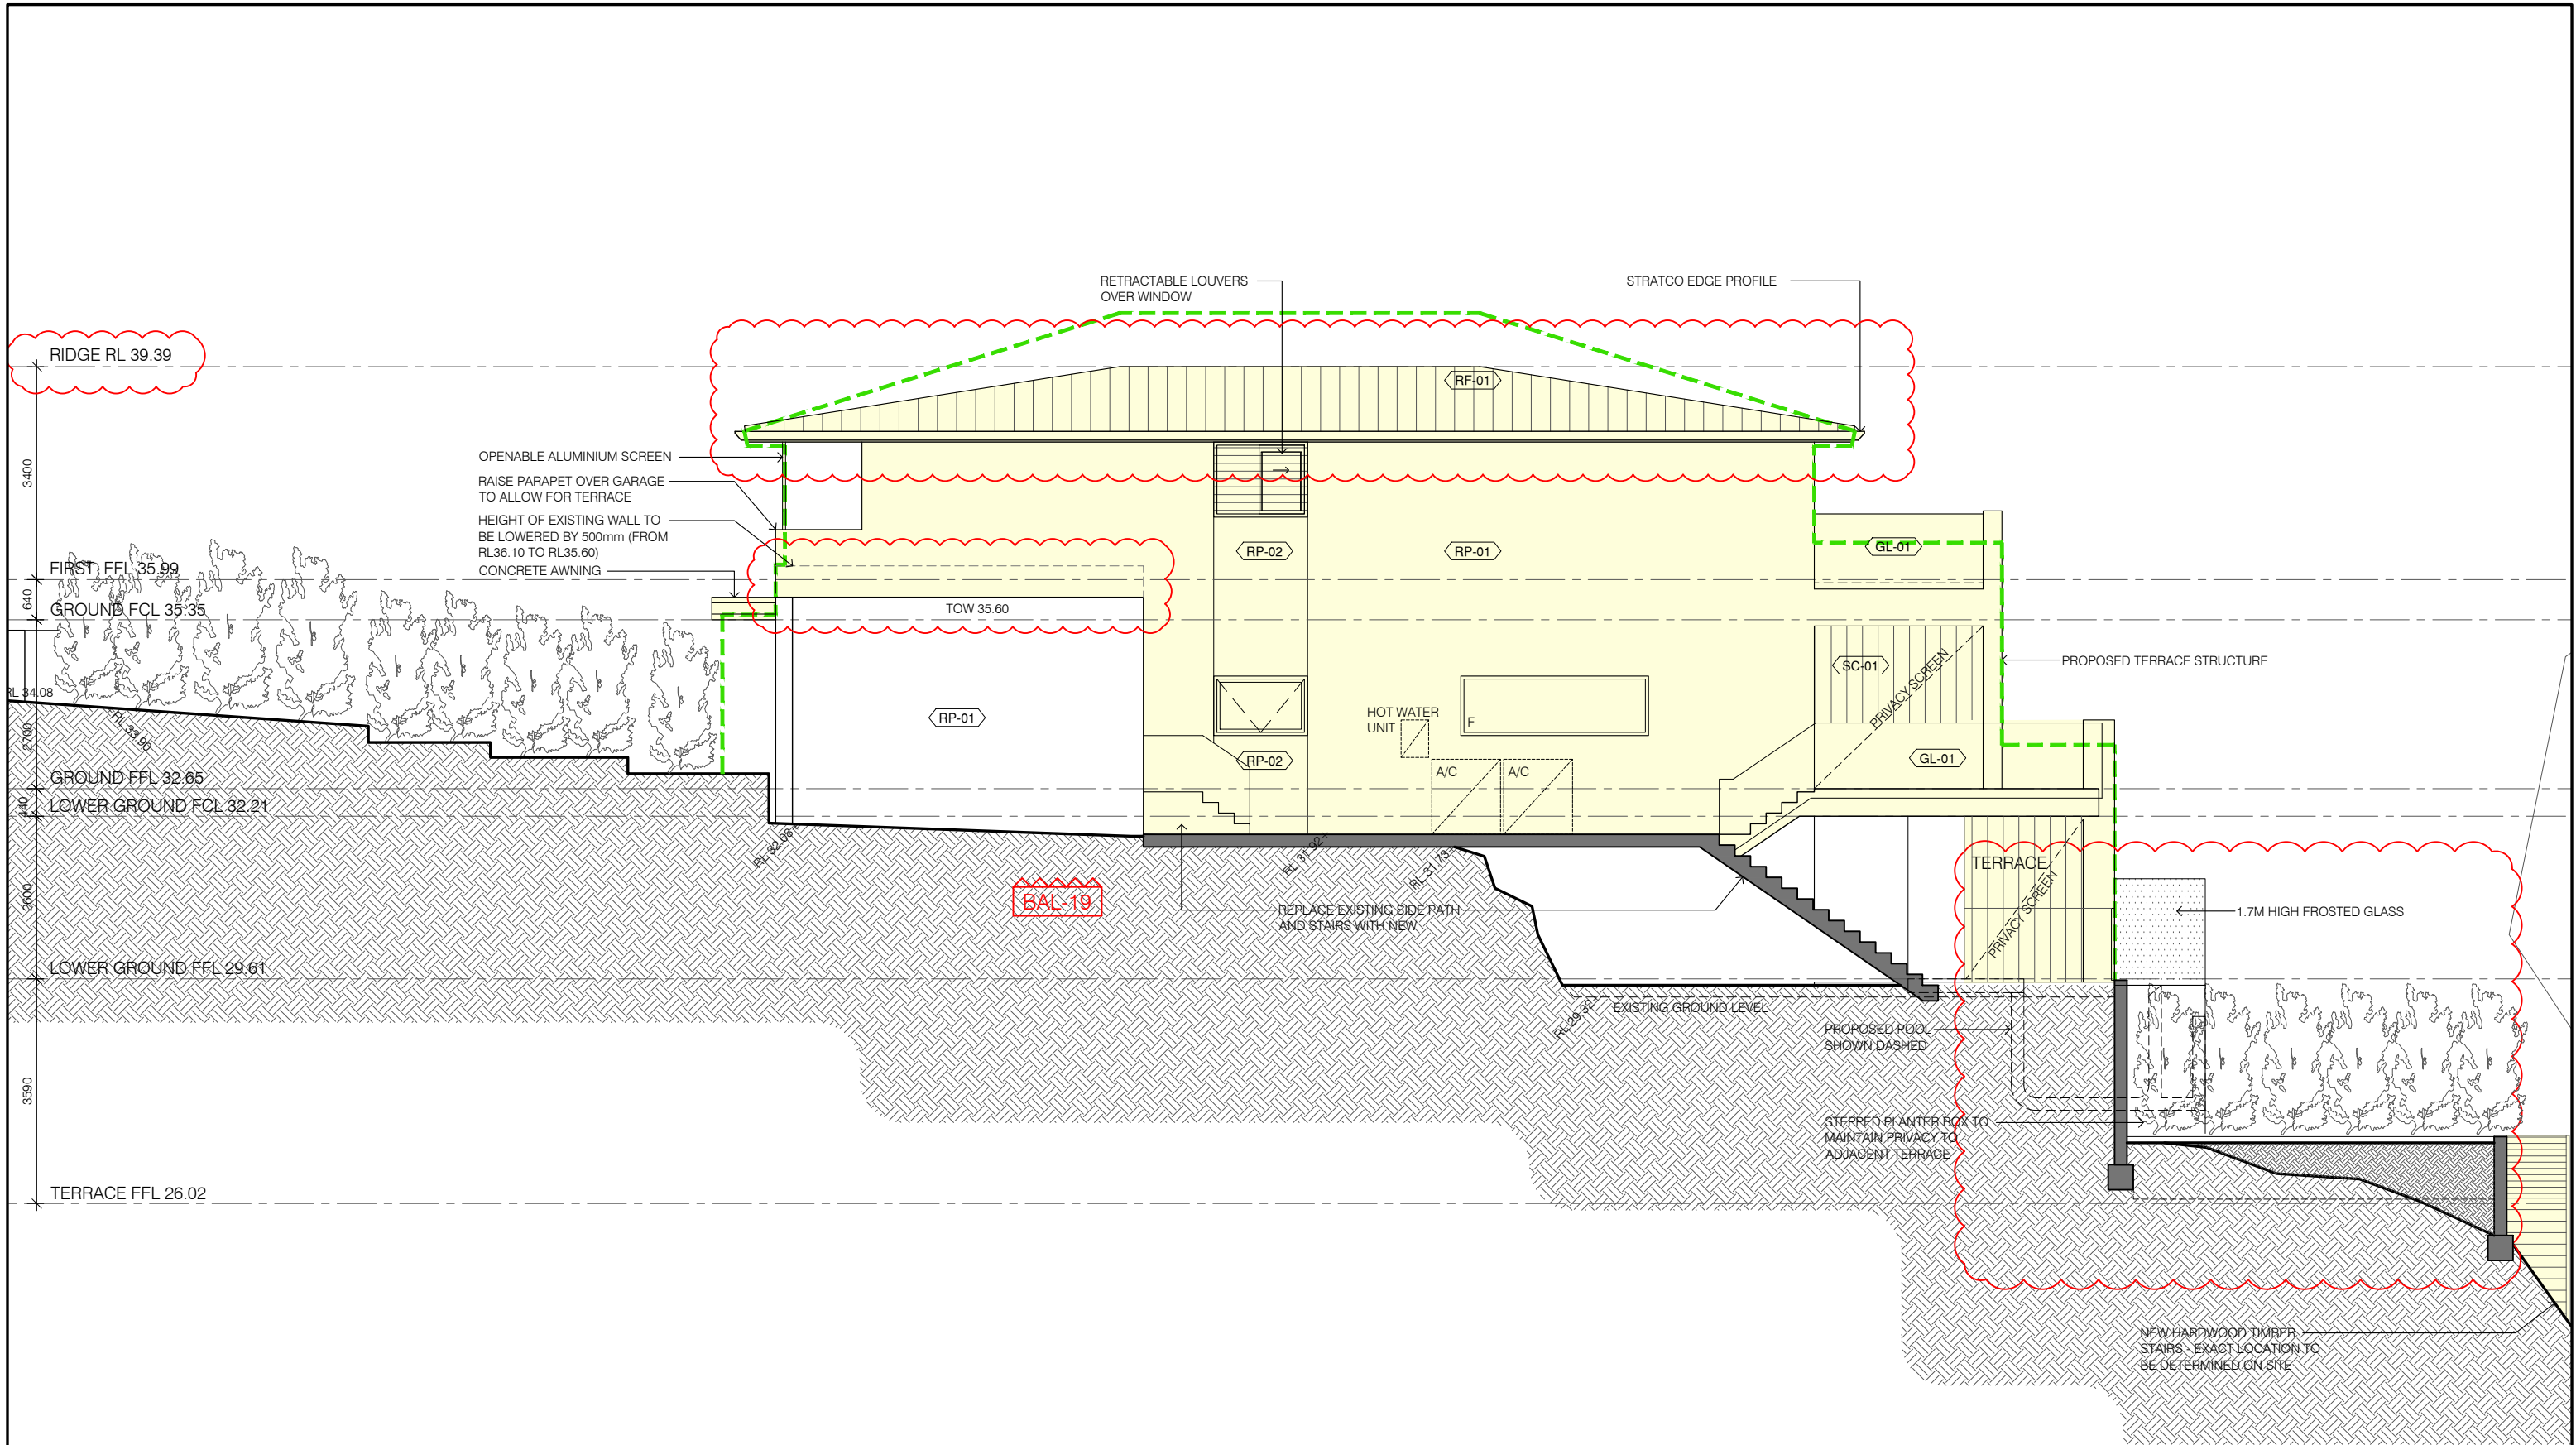

1 SOUTH ELEVATION  
1303 SCALE 1:100 @ A3

ARCHITECT

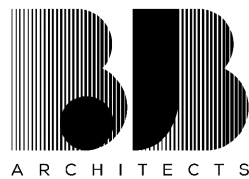

t: 02 8970 5417  
e: studio@bjbarchitects.com.au  
a: 3.09/77 Dunning Ave  
Rosebery NSW 2018

BJB Architects Pty Ltd  
Nominated Architect:  
Barry Babikian NSW Reg No 8806

LEGEND

- EXISTING STRUCTURE
- NEW STRUCTURE
- PROPOSED AREA OF WORKS
- PREVIOUS DA SUBMISSION

EXTERNAL FINISHES LEGEND

- RP-01 RENDER & PAINT DULUX MCGINLEY
- RP-02 RENDER & PAINT DULUX RAKU
- FB-01 PGH BRICKS - PEWTER METALLIC
- RF-01 COLORBOND LONGLINE 305 ROOFING, WOODLAND GREY
- GL-01 GLASS BALUSTRADE
- SC-01 TIMBER SCREEN

ISSUE	AMENDMENT	DATE
E	Development Application	13.10.2020
F	DA Amendment	12.04.2021
G	Amendment - LEC	10.05.2022
H	Amendment - LEC	24.05.2022

PROJECT

75 COOLAWIN ROAD,  
NORTHBRIDGE  
NEW DWELLING

ELEVATIONS

SCALE: 1:100 @ A3 DATE: 24.05.2022


ISSUE: H - Amendment - LEC

THIS DOCUMENT IS THE COPYRIGHT OF BJB ARCHITECTS. ALL INFORMATION ILLUSTRATED ON THIS DOCUMENT IS TO BE CHECKED AND VERIFIED ON SITE. IN THE EVENT OF DISCREPANCIES REFER TO BJB ARCHITECTS PRIOR TO COMMENCEMENT OF THE WORK. DO NOT SCALE DRAWINGS MANUALLY OR ELECTRONICALLY.


2020-031  
A1303






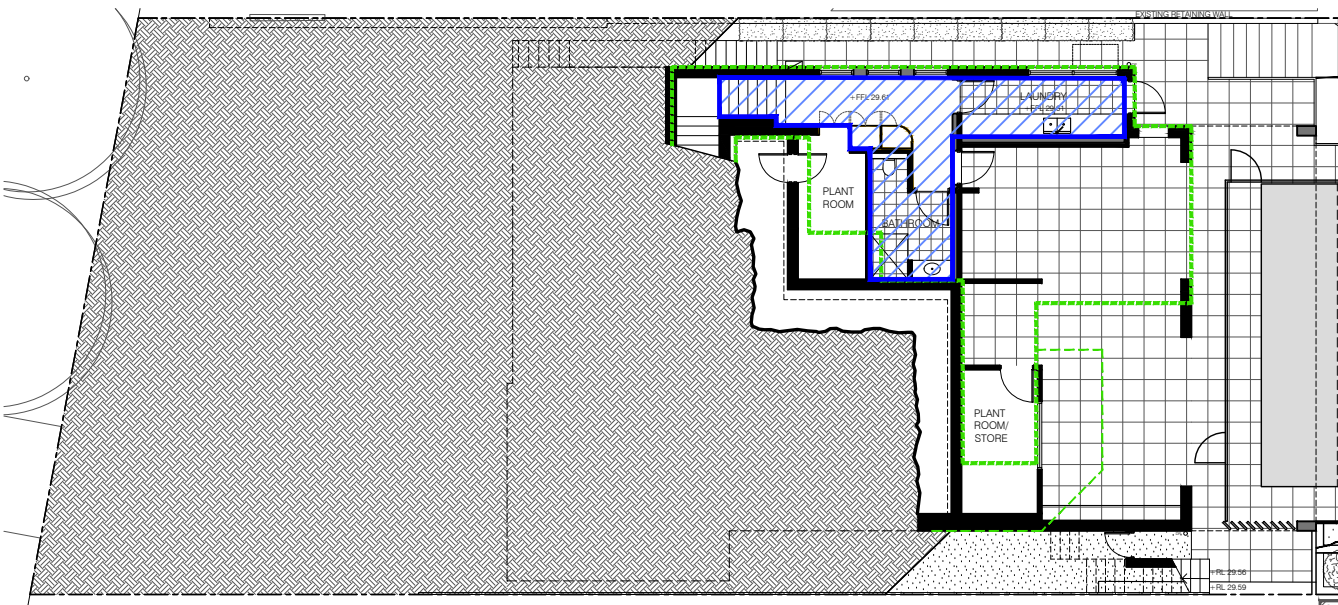


LOWER GROUND FLOOR PLAN  
SCALE 1:200 @ A3

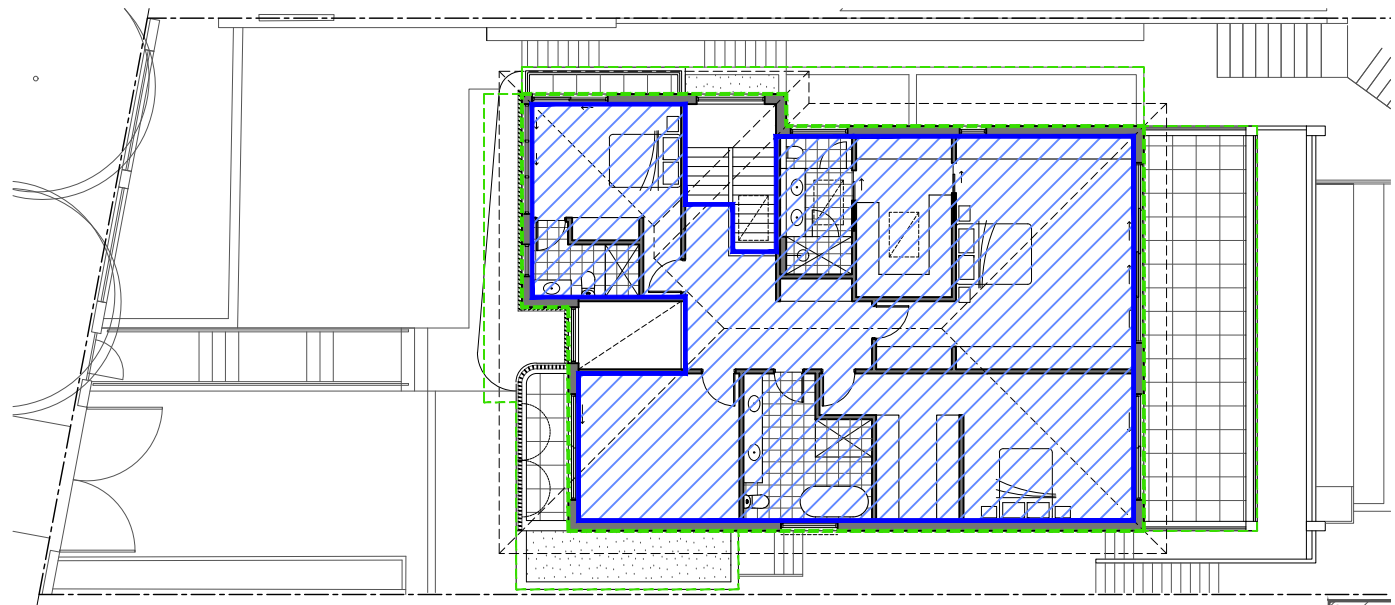

FIRST FLOOR PLAN  
SCALE 1:200 @ A3

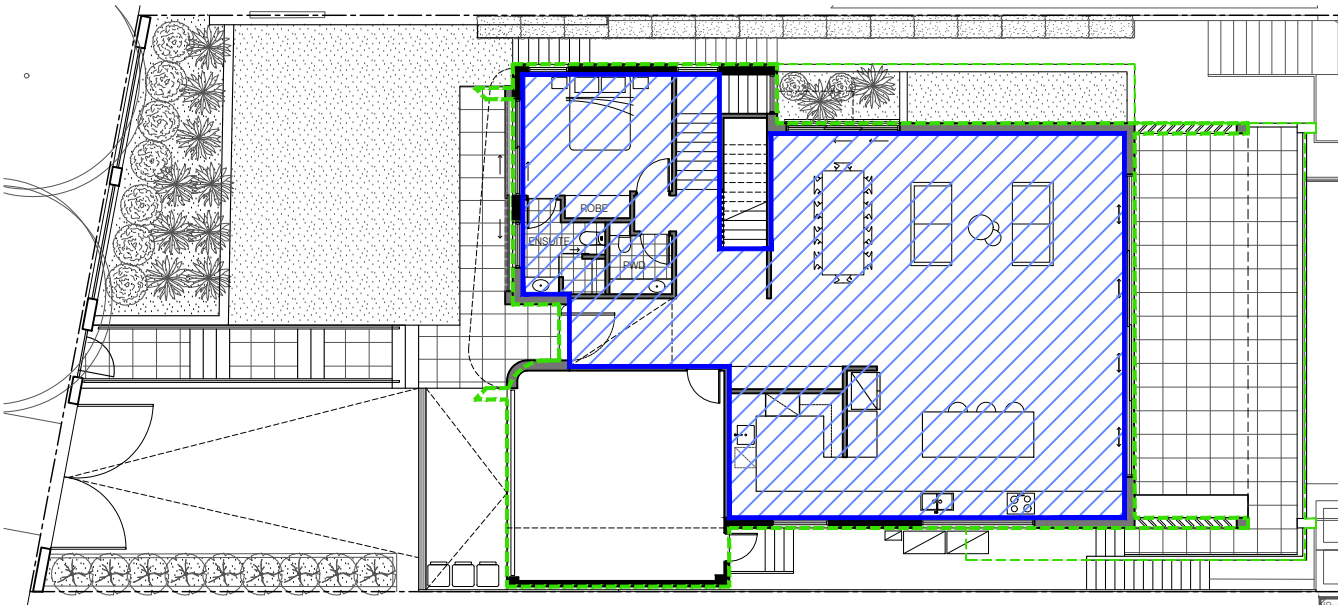

GROUND FLOOR PLAN  
SCALE 1:200 @ A3

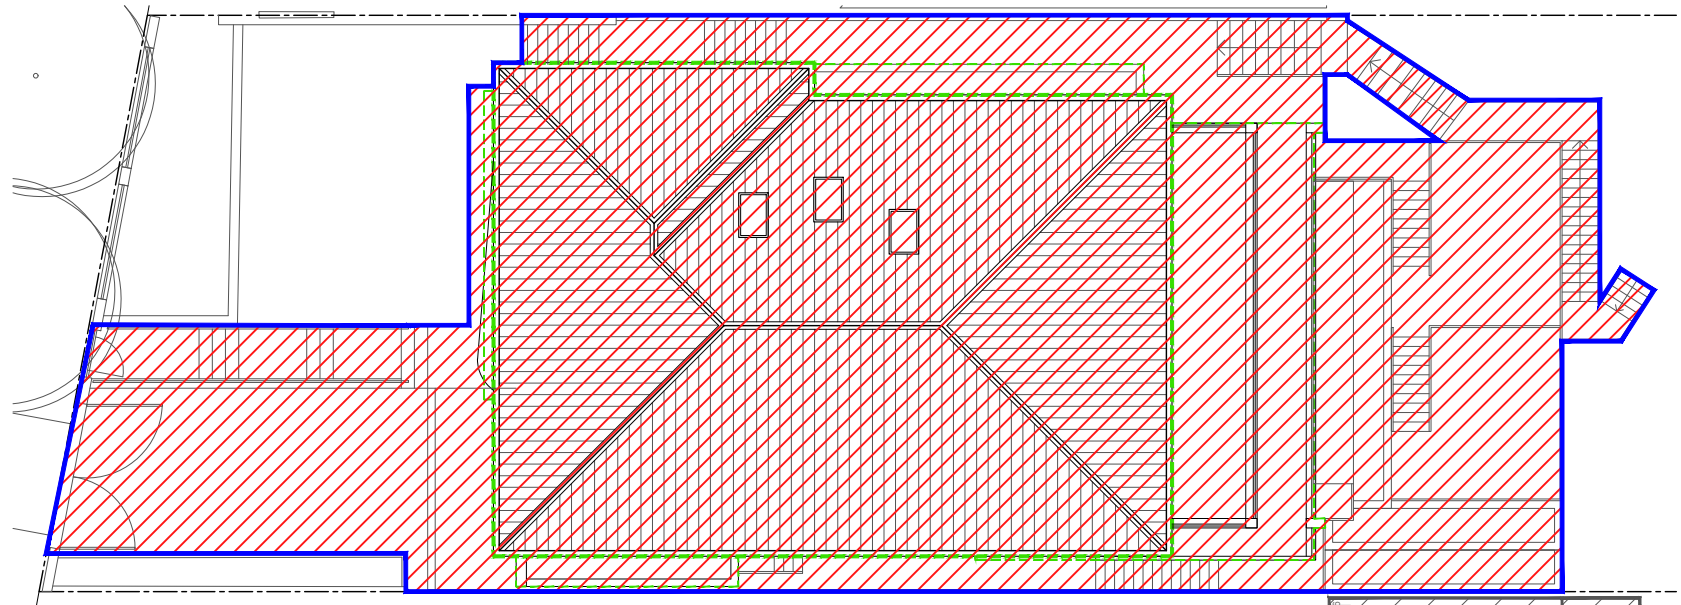

ROOF PLAN  
SCALE 1:200 @ A3

FLOOR AREA CALCULATIONS		
CONTROL	PREVIOUS DA APPROVAL	PROPOSED
SITE AREA	1176sqm	
LOWER GROUND FLOOR	48sqm	23.7sqm
GROUND FLOOR	138.3sqm	141.4sqm
FIRST FLOOR	151.9sqm	146.4sqm
TOTAL FLOOR AREA	338.2sqm	311.5sqm
RATIO	0.28:1	0.26:1
COMPLIANCE (CONTROL: 0.27:1 = 317.52sqm)	NO, (REFER TO CLAUSE 4.6)	YES

IMPERVIOUS AREA CALCULATIONS	
CONTROL	PROPOSED
SITE AREA	1176sqm
TOTAL	502.7sqm
PERCENTAGE	42.7%



ARCHITECT




t: 02 8970 5417  
e: studio@bjbarchitects.com.au  
a: 3.09/77 Dunning Ave  
Rosebery NSW 2018

BJB Architects Pty Ltd  
Nominated Architect:  
Barry Babikian NSW Reg No 8806

LEGEND:

-  GROSS FLOOR AREA
-  IMPERVIOUS AREA

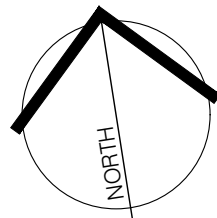

ISSUE	AMENDMENT	DATE
E	Development Application	13.10.2020
F	DA Amendment	12.04.2021
G	Amendment - LEC	10.05.2022
H	Amendment - LEC	24.05.2022

PROJECT

75 COOLAWIN ROAD,  
NORTHBRIDGE  
NEW DWELLING

FLOOR AREA & IMPERVIOUS AREA CALCULATIONS


SCALE: 1:200 @ A3 DATE: 24.05.2022

ISSUE: H - Amendment - LEC

THIS DOCUMENT IS THE COPYRIGHT OF BJB ARCHITECTS.  
ALL INFORMATION ILLUSTRATED ON THIS DOCUMENT IS  
TO BE CHECKED AND VERIFIED ON SITE.  
IN THE EVENT OF DISCREPANCIES REFER TO BJB  
ARCHITECTS PRIOR TO COMMENCEMENT OF THE WORK.  
DO NOT SCALE DRAWINGS MANUALLY OR  
ELECTRONICALLY.

2020-031

A1401

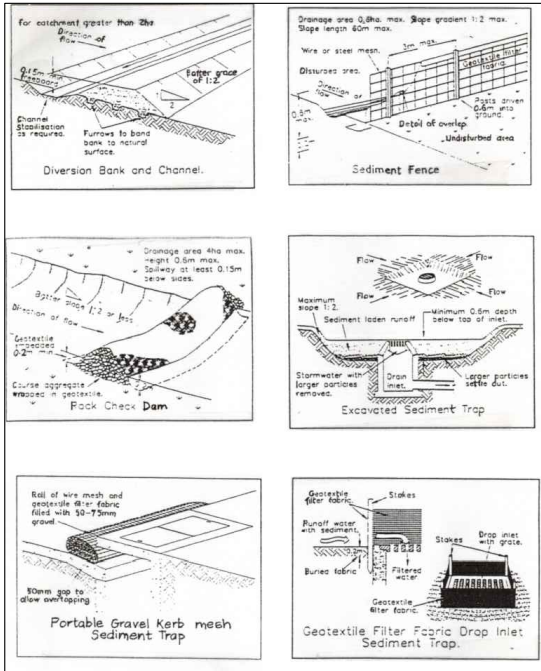

EROSION CONTROL NOTES:

1. ALL EROSION AND SILTATION CONTROL DEVICES ARE TO BE PLACED PRIOR TO COMMENCEMENT OF ANY CONSTRUCTION WORKS AND ALL SILT TRAPS ARE TO HAVE DEPOSITED SILT REMOVED REGULARLY DURING CONSTRUCTION.
2. INSTALL TEMPORARY SEDIMENT BARRIERS TO ALL INLET PITS LIKELY TO COLLECT SILT LADDED WATER, TO COUNCIL STANDARDS.

DRAINAGE NOTES:

ALL WORK CARRIED OUT SHALL COMPLY TO AND BE IN ACCORDANCE WITH THE REQUIREMENTS OF AS 3500, THE NEW SOUTH WALES PLUMBING & DRAINAGE 'CODE OF PRACTICE', AND ALL OTHER RELEVANT AUSTRALIAN STANDARDS AND CODES OF PRACTICE INCLUDING THE B.C.A.


WASTE MANAGEMENT NOTES:

ANY CONSTRUCTION WASTE IS TO BE RECYCLED WHERE APPLICABLE AND DISPOSED OF IN ACCORDANCE WITH WILLOUGHBY COUNCIL'S GUIDELINES.


DEMOLITION REQUIREMENTS:

ALL DEMOLITION WORK MUST BE CARRIED OUT IN ACCORDANCE WITH THE FOLLOWING:

- A. COMPLIANCE WITH THE REQUIREMENTS OF AUSTRALIAN STANDARD AS 2601 'THE DEMOLITION OF STRUCTURES' WITH SPECIFIC REFERENCE TO HEALTH AND SAFETY OF THE PUBLIC, HEALTH AND SAFETY OF THE SITE PERSONNEL, PROTECTION OF ADJOINING BUILDINGS AND PROTECTION OF THE IMMEDIATE ENVIRONMENT;
- B. ALL WORKS INVOLVING THE DEMOLITION, REMOVAL, TRANSPORT AND DISPOSAL OF ASBESTOS CEMENT MUST BE CARRIED OUT IN ACCORDANCE WITH THE 'WORKSAFE CODE OF PRACTICE FOR REMOVAL OF ASBESTOS' AND THE REQUIREMENTS OF THE WORKCOVER AUTHORITY OF NSW AND THE DEPARTMENT OF ENVIRONMENT, CLIMATE CHANGE AND WATER
- C. ALL BUILDING MATERIALS ARISING FROM THE DEMOLITION MUST BE DISPOSED OF IN AN APPROVED MANNER IN ACCORDANCE WITH PART C.8 OF WILLOUGHBY CITY COUNCIL 2006 - WASTE MANAGEMENT AND ANY APPLICABLE REQUIREMENTS OF THE DEPARTMENT OF ENVIRONMENT, CLIMATE CHANGE AND WATER
- D. SANITARY DRAINAGE, STORMWATER DRAINAGE, WATER, ELECTRICITY AND TELECOMMUNICATIONS MUST BE DISCONNECTED IN ACCORDANCE WITH THE REQUIREMENTS OF THE RESPONSIBLE AUTHORITIES
- E. THE GENERATION OF DUST AND NOISE ON SITE MUST BE CONTROLLED
- F. THE SITE MUST BE SECURED TO PROHIBIT UNAUTHORISED ENTRY
- G. SUITABLE PROVISION MUST BE MADE TO CLEAN THE WHEELS AND BODIES OF ALL VEHICLES LEAVING THE SITE TO PREVENT THE TRACKING OF DEBRIS AND SOIL ONTO THE PUBLIC WAY
- H. ALL TRUCKS AND VEHICLES ASSOCIATED WITH THE DEMOLITION, INCLUDING THOSE DELIVERING TO OR REMOVING MATERIAL FROM THE SITE, MUST ONLY HAVE ACCESS TO THE SITE DURING WORK HOURS NOMINATED BY COUNCIL AND ALL LOADS MUST BE COVERED
- I. ALL VEHICLES TAKING MATERIALS FROM THE SITE MUST BE LOADED WHOLLY WITHIN THE PROPERTY UNLESS OTHERWISE PERMITTED BY COUNCIL
- J. NO WASTE COLLECTION SKIPS, SPOIL, EXCAVATION OR DEMOLITION MATERIAL FROM THE SITE MUST BE DEPOSITED ON THE PUBLIC ROAD, FOOTPATH, PUBLIC PLACE OR COUNCIL OWNED PROPERTY WITHOUT THE APPROVAL OF COUNCIL
- K. THE PERSON ACTING ON THIS CONSENT MUST ENSURE THAT ALL CONTRACTORS AND SUBCONTRACTORS ASSOCIATED WITH THE DEMOLITION ARE FULLY AWARE OF THESE REQUIREMENTS

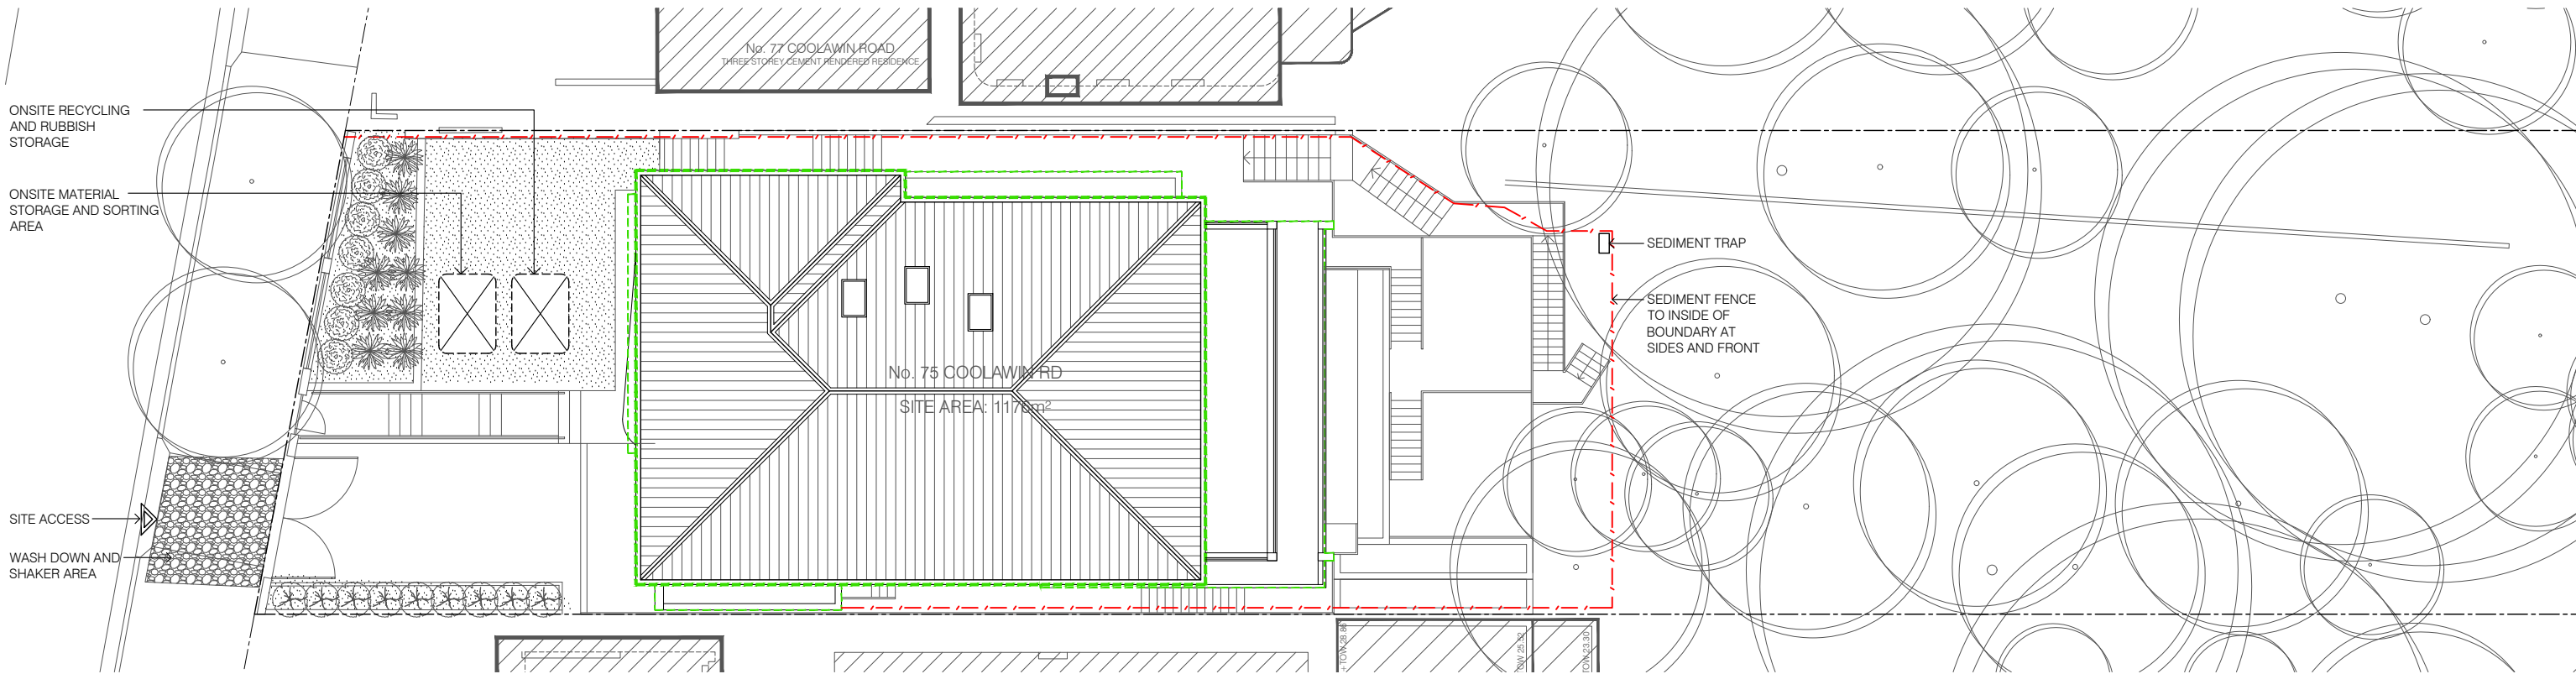


ARCHITECT

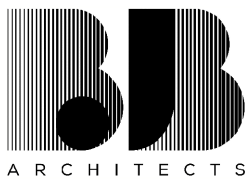

t: 02 8970 5417  
e: studio@bjbarchitects.com.au  
a: 3.09/77 Dunning Ave  
Rosebery NSW 2018

BJB Architects Pty Ltd  
Nominated Architect:  
Barry Babikian NSW Reg No 8806

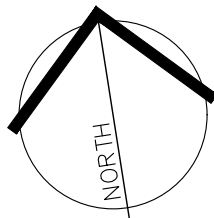

ISSUE	AMENDMENT	DATE
E	Development Application	13.10.2020
F	DA Amendment	12.04.2021
G	Amendment - LEC	10.05.2022
H	Amendment - LEC	24.05.2022

PROJECT

75 COOLAWIN ROAD,  
NORTHBRIDGE  
NEW DWELLING

SITE MANAGEMENT PLAN

SCALE: 1:200 @ A3 DATE: 24.05.2022



ISSUE: H - Amendment - LEC

THIS DOCUMENT IS THE COPYRIGHT OF BJB ARCHITECTS. ALL INFORMATION ILLUSTRATED ON THIS DOCUMENT IS TO BE CHECKED AND VERIFIED ON SITE. IN THE EVENT OF DISCREPANCIES REFER TO BJB ARCHITECTS PRIOR TO COMMENCEMENT OF THE WORK. DO NOT SCALE DRAWINGS MANUALLY OR ELECTRONICALLY.

2020-031

A1402



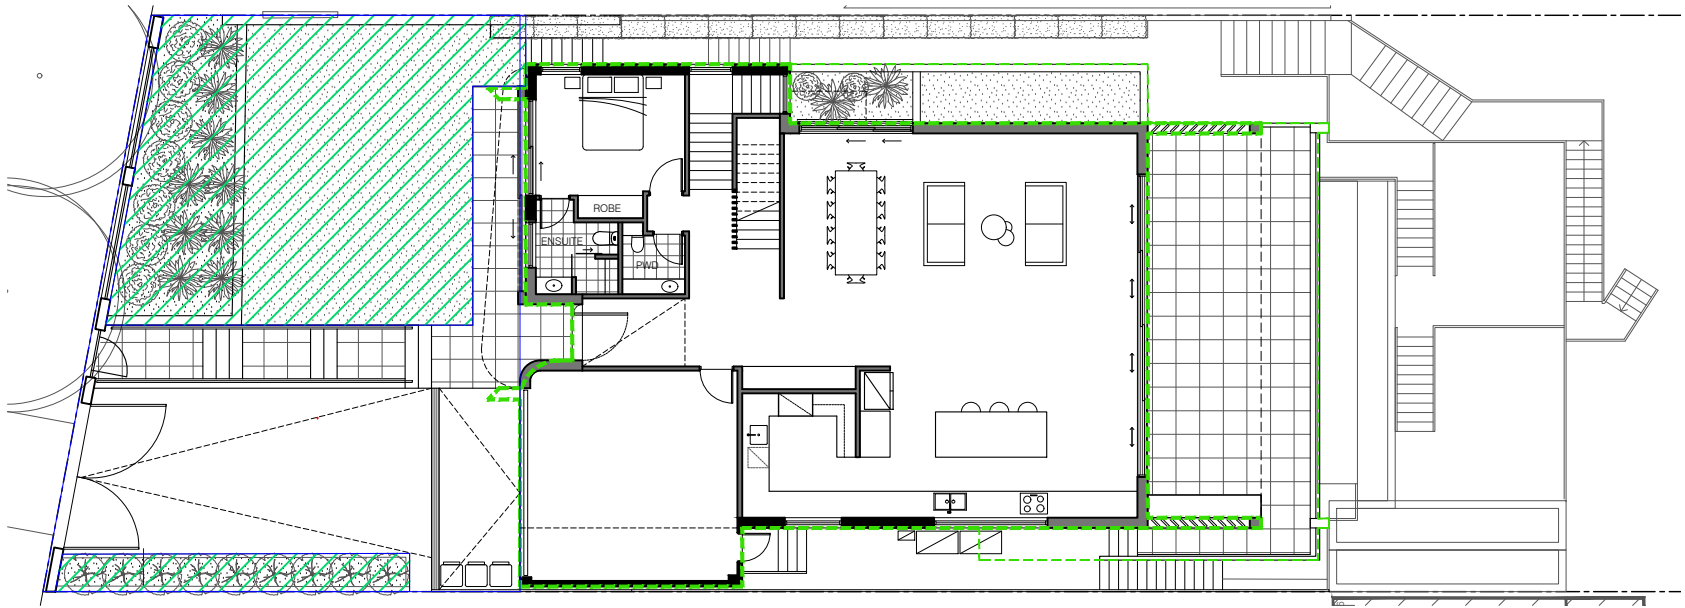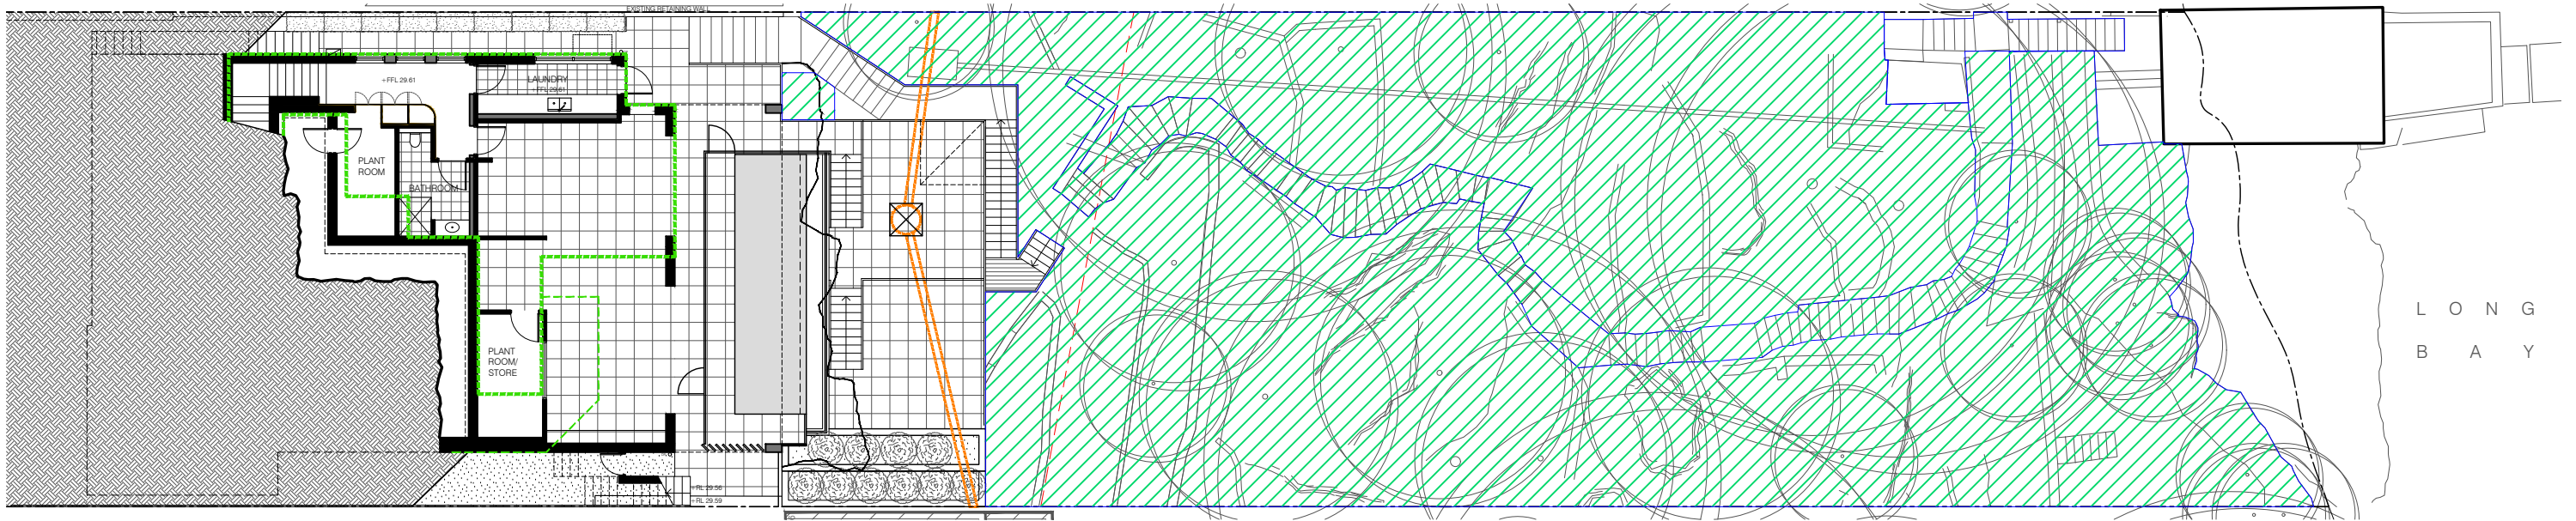

LANDSCAPE CALCULATIONS			
CONTROL		PROPOSED	COMPLIANCE
SITE AREA	1176sqm		
SOFT LANDSCAPING (65% - 150sqm)	614.4sqm	641.1sqm	YES
LANDSCAPING FRONT OF BUILDING LINE (50% OF 170.5sqm)	85.25sqm	85.3sqm	YES

ARCHITECT

**BB** ARCHITECTS

t: 02 8970 5417  
e: studio@bjbarchitects.com.au  
a: 3.09/77 Dunning Ave  
Rosebery NSW 2018

BJB Architects Pty Ltd  
Nominated Architect:  
Barry Babikian NSW Reg No 8806

LEGEND:

NATURAL LANDSCAPED AREA

ISSUE	AMENDMENT	DATE
E	Development Application	13.10.2020
F	DA Amendment	12.04.2021
G	Amendment - LEC	10.05.2022
H	Amendment - LEC	24.05.2022

PROJECT

**75 COOLAWIN ROAD,  
NORTHBRIDGE**

NEW DWELLING

NATURAL LANDSCAPED AREA CALCULATION PLAN

SCALE: 1:200 @ A3 DATE: 24.05.2022


ISSUE: H - Amendment - LEC

THIS DOCUMENT IS THE COPYRIGHT OF BJB ARCHITECTS. ALL INFORMATION ILLUSTRATED ON THIS DOCUMENT IS TO BE CHECKED AND VERIFIED ON SITE. IN THE EVENT OF DISCREPANCIES REFER TO BJB ARCHITECTS PRIOR TO COMMENCEMENT OF THE WORK. DO NOT SCALE DRAWINGS MANUALLY OR ELECTRONICALLY.


2020-031

**A1403**




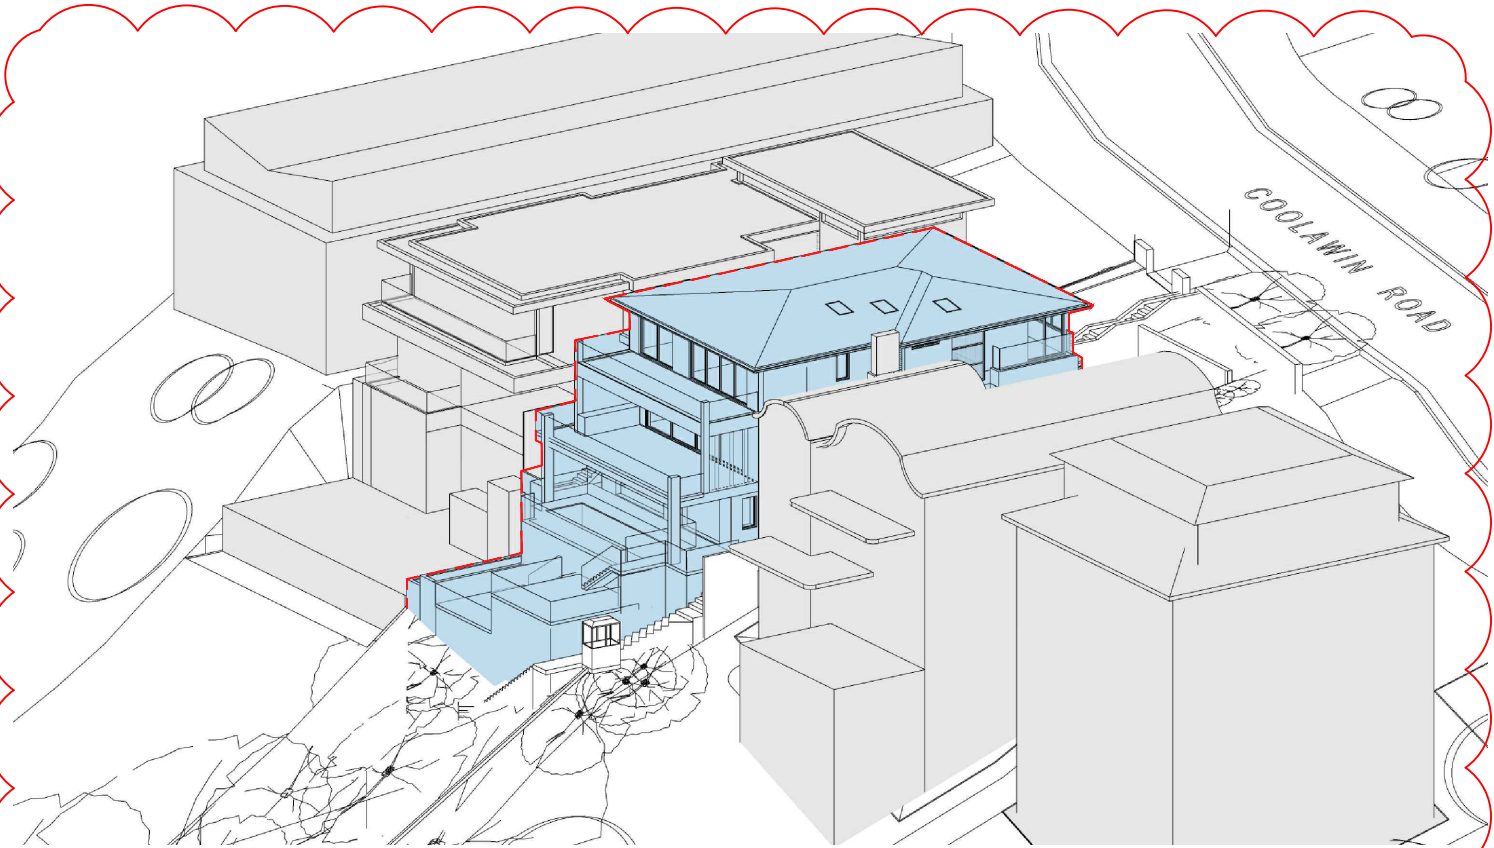


PROPOSED AMENDMENTS - REV H

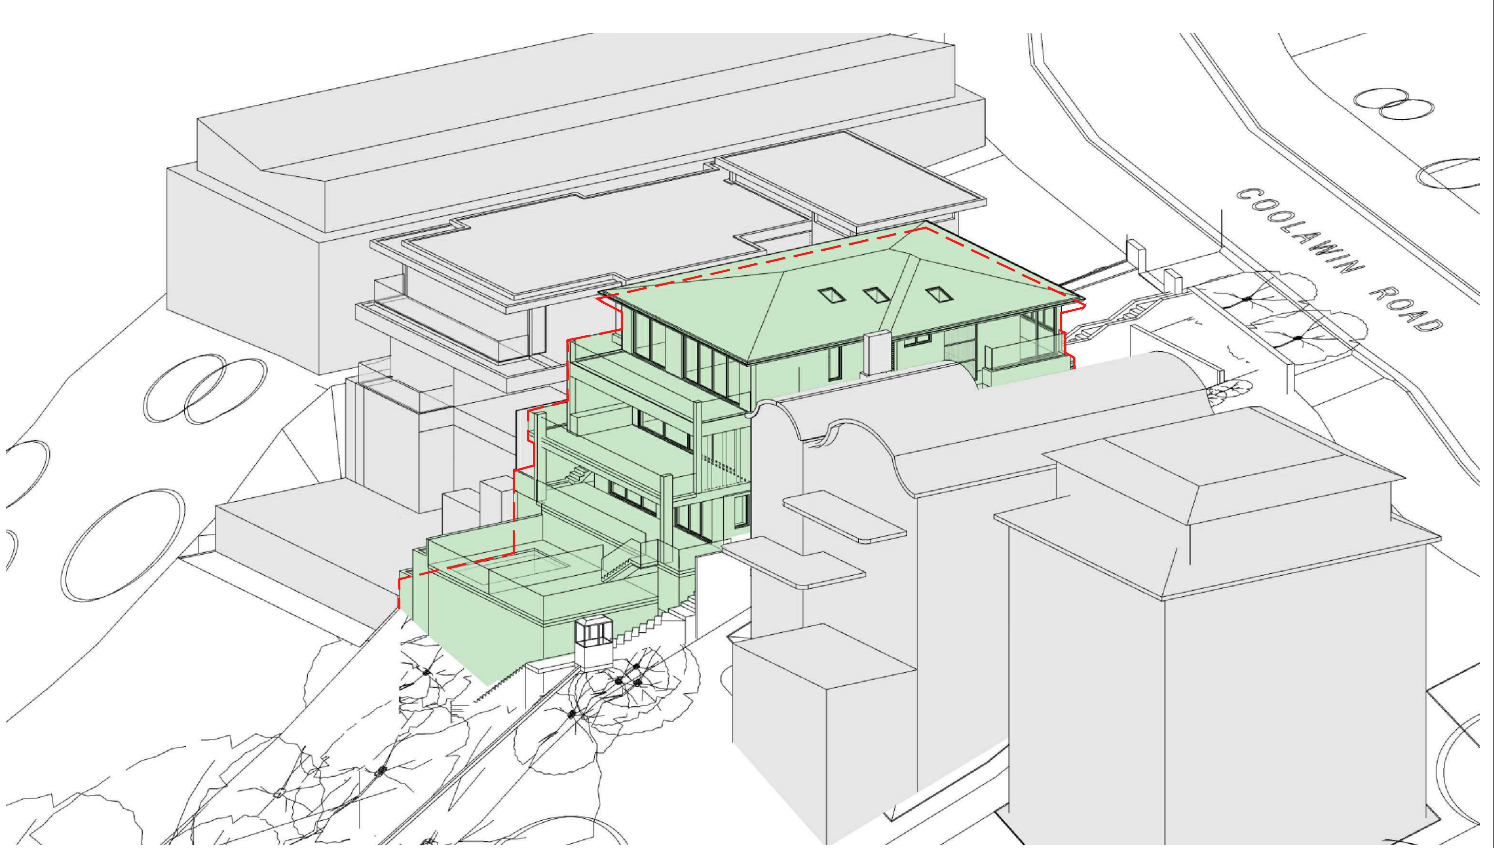

PREVIOUS REVISION - REV F

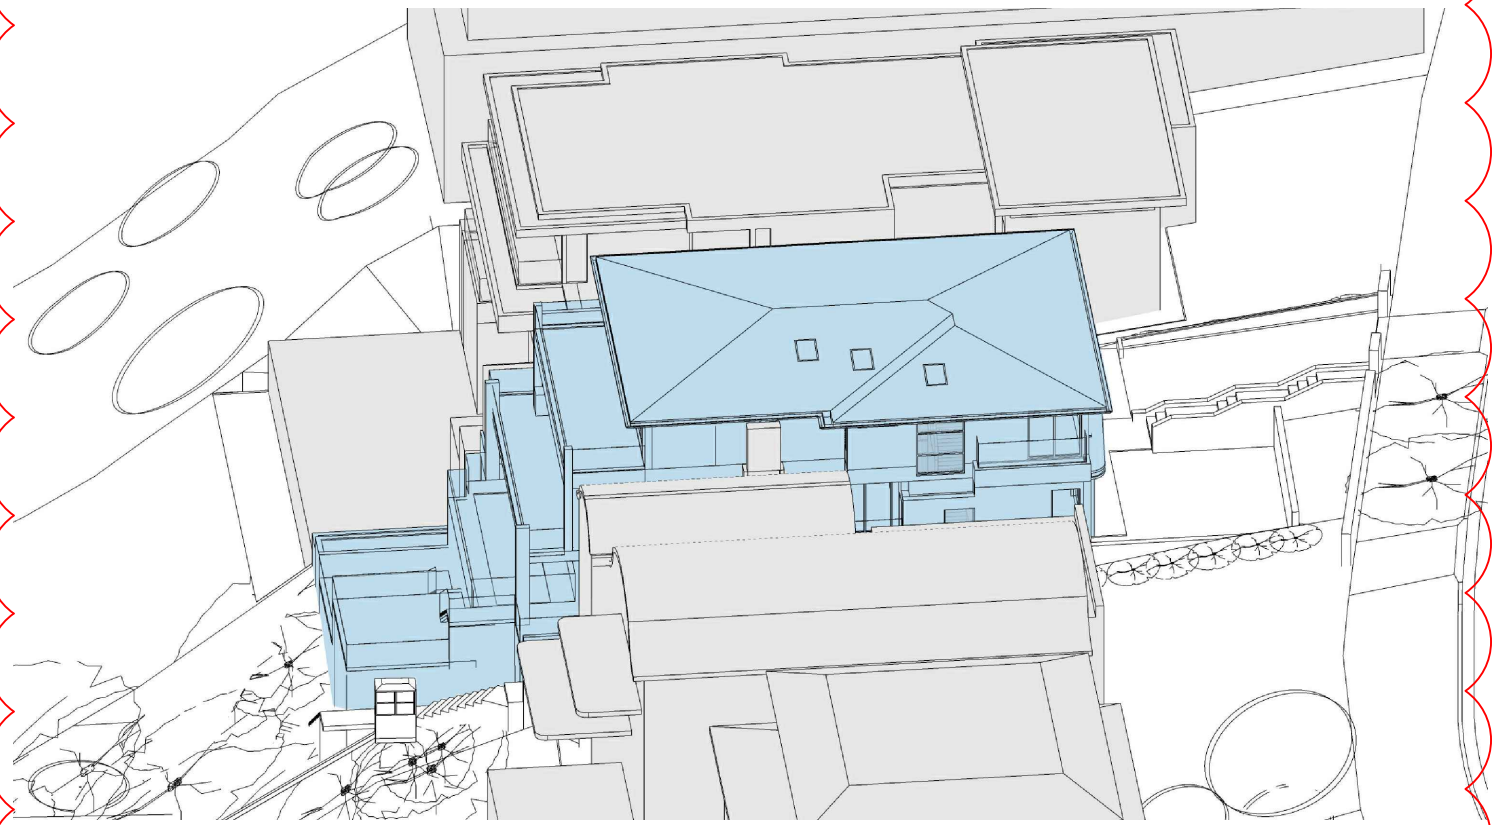


PROPOSED AMENDMENTS - REV H

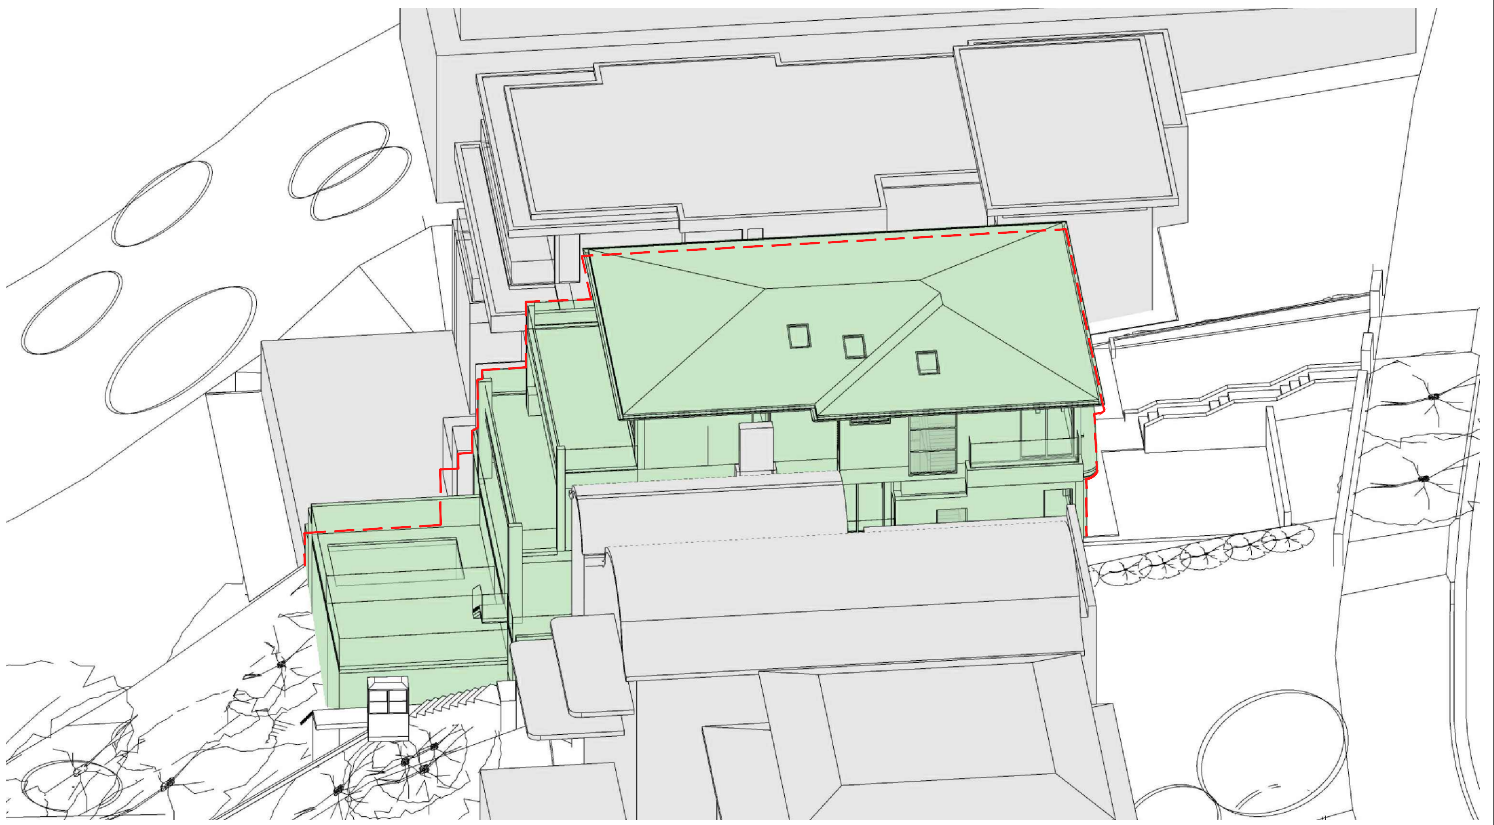

PREVIOUS REVISION - REV F

ARCHITECT

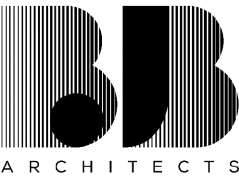

t: 02 8970 5417  
e: studio@bjbarchitects.com.au  
a: 3.09/77 Dunning Ave  
Rosebery NSW 2018

BJB Architects Pty Ltd  
Nominated Architect:  
Barry Babikian NSW Reg No 8806

LEGEND:



PROPOSED BUILDING



RED DASHED LINE INDICATES  
EXTENT OF REV F S4.55



PREVIOUS REVISION - REV F

ISSUE	AMENDMENT	DATE
E	Development Application	13.10.2020
F	DA Amendment	12.04.2021
G	Amendment - LEC	10.05.2022
H	Amendment - LEC	24.05.2022

PROJECT

75 COOLAWIN ROAD,  
NORTHBRIDGE  
NEW DWELLING

SOLAR EYE DIAGRAMS

SCALE: NTS @ A3 DATE: 24.05.2022

ISSUE: H - Amendment - LEC

THIS DOCUMENT IS THE COPYRIGHT OF BJB ARCHITECTS.  
ALL INFORMATION ILLUSTRATED ON THIS DOCUMENT IS  
TO BE CHECKED AND VERIFIED ON SITE.  
IN THE EVENT OF DISCREPANCIES REFER TO BJB  
ARCHITECTS PRIOR TO COMMENCEMENT OF THE WORK.  
DO NOT SCALE DRAWINGS MANUALLY OR  
ELECTRONICALLY.


2020-031

A1501



12PM - WINTER SOLSTICE 22ND JUNE


3PM - WINTER SOLSTICE 22ND JUNE

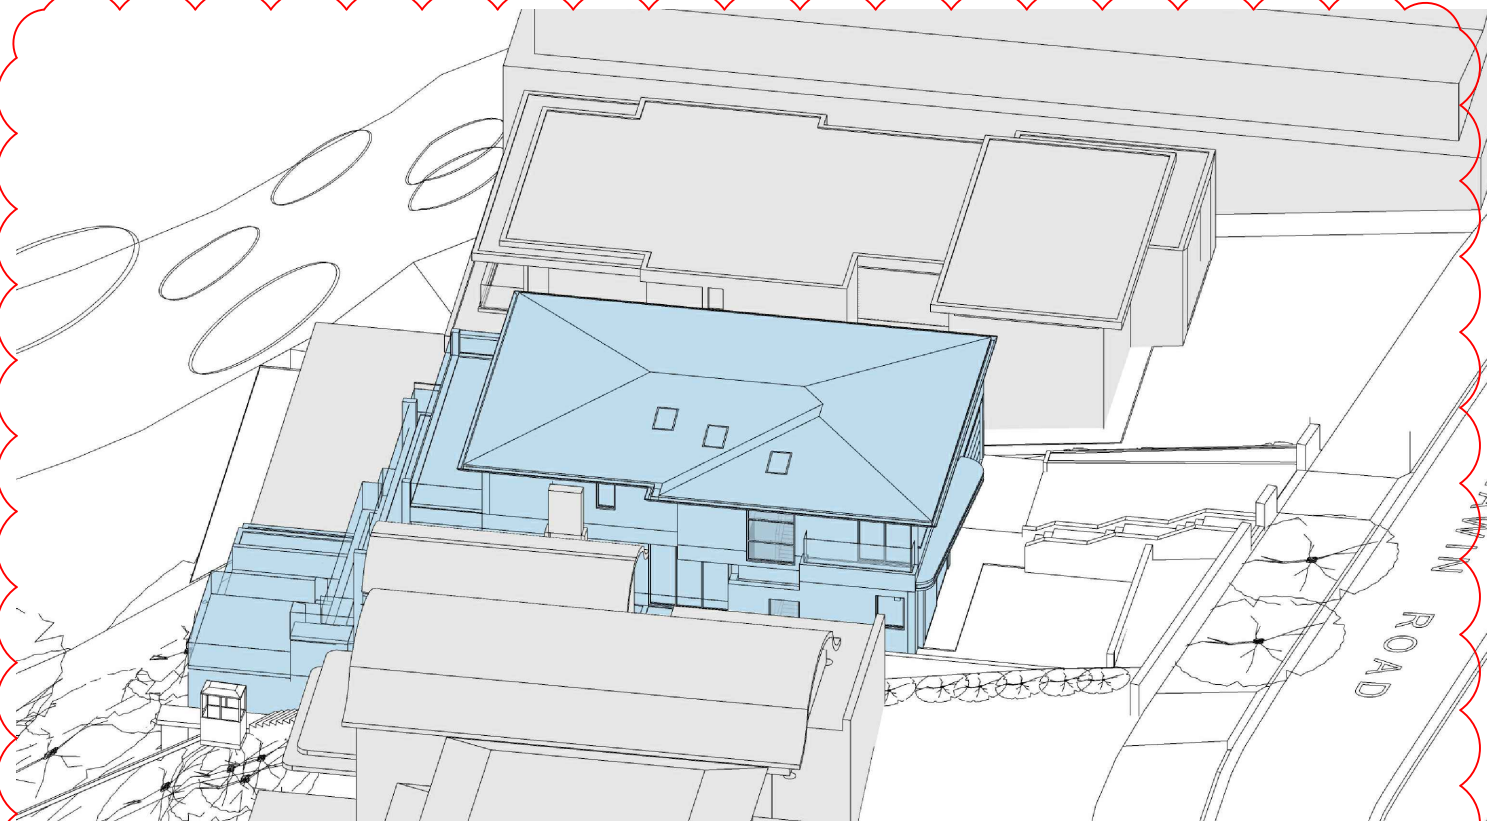


PROPOSED AMENDMENTS - REV H



PREVIOUS REVISION - REV F

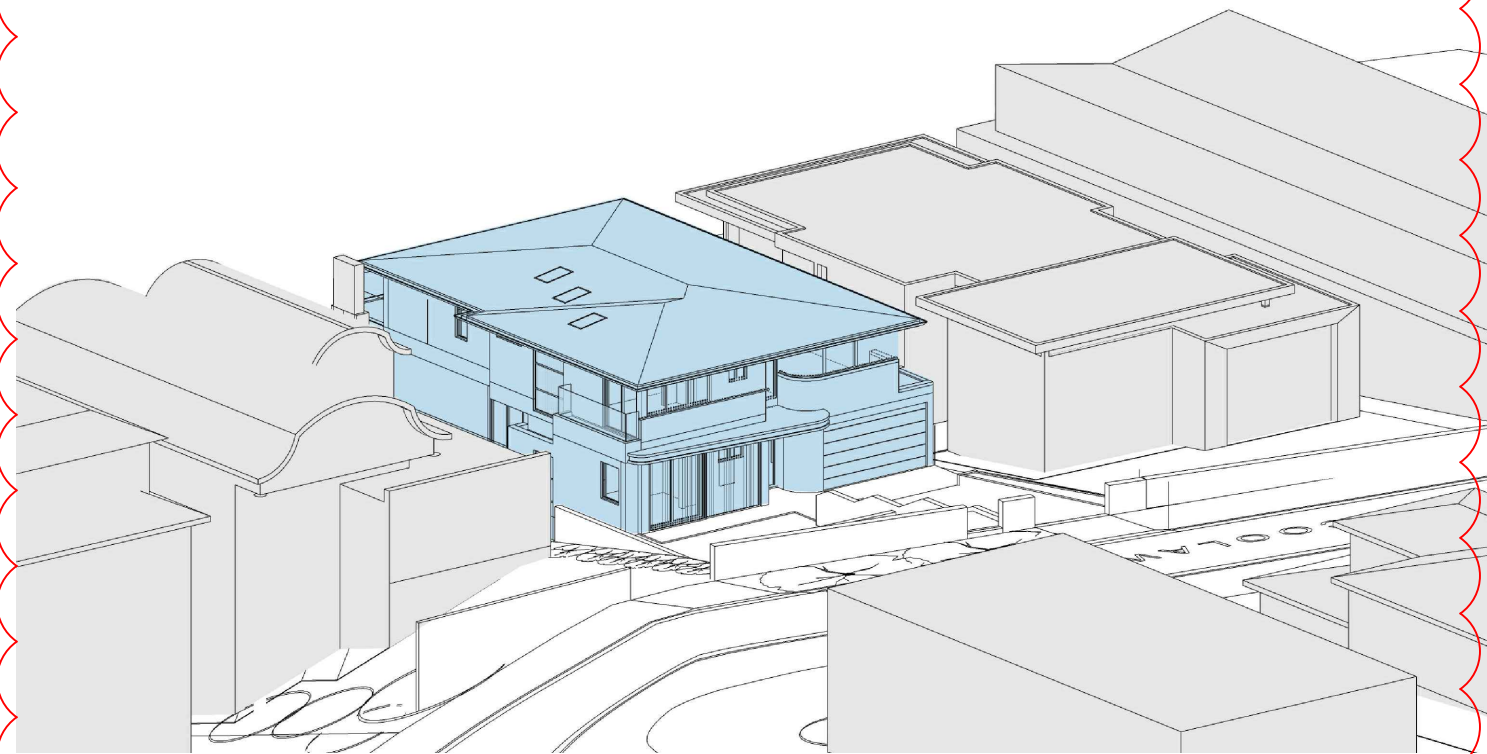

PROPOSED AMENDMENTS - REV H

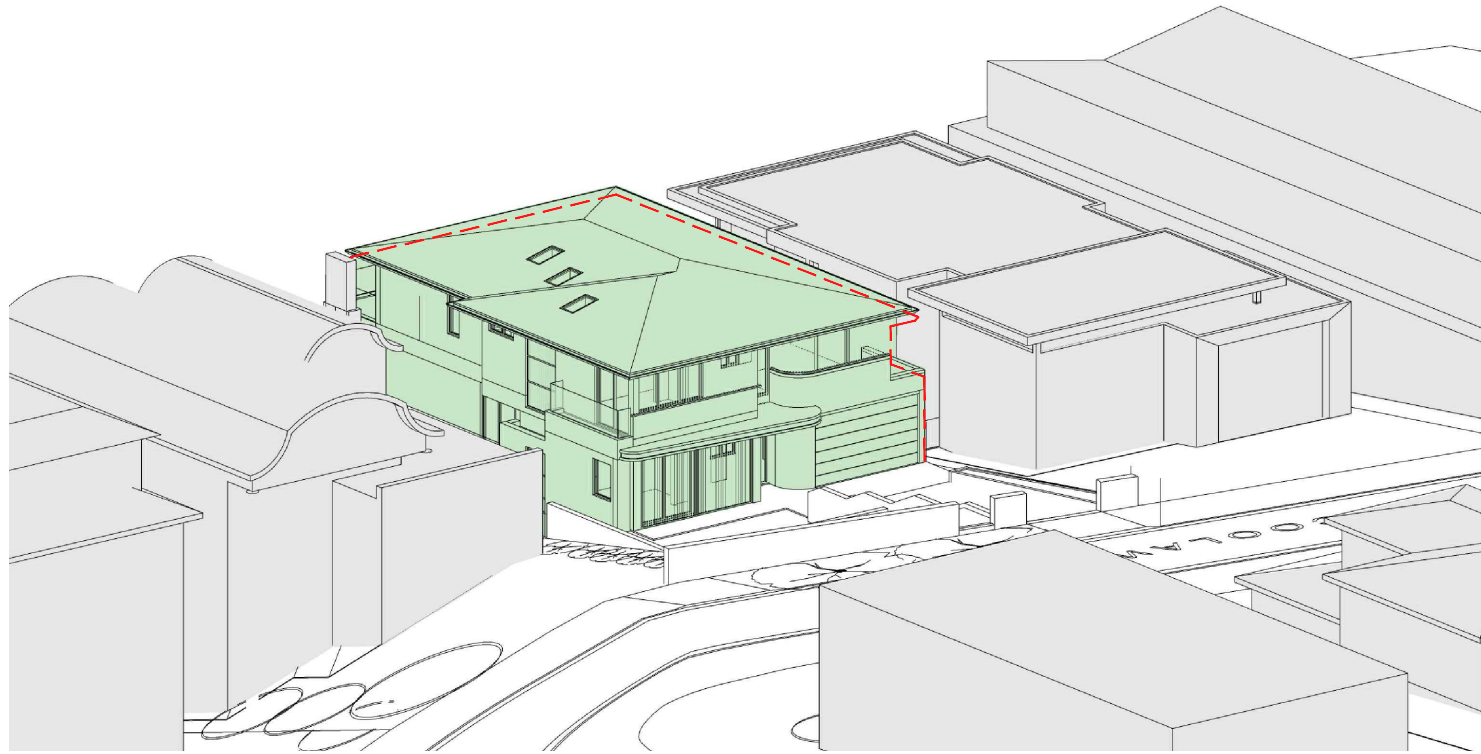

PREVIOUS REVISION - REV F

ARCHITECT



t: 02 8970 5417  
e: studio@bjbarchitects.com.au  
a: 3.09/77 Dunning Ave  
Rosebery NSW 2018

BJB Architects Pty Ltd  
Nominated Architect:  
Barry Babikian NSW Reg No 8806

LEGEND:



PROPOSED BUILDING



PREVIOUS REVISION - REV F



RED DASHED LINE INDICATES  
EXTENT OF REV F S4.55

ISSUE	AMENDMENT	DATE
E	Development Application	13.10.2020
F	DA Amendment	12.04.2021
G	Amendment - LEC	10.05.2022
H	Amendment - LEC	24.05.2022

PROJECT

75 COOLAWIN ROAD,  
NORTHBRIDGE  
NEW DWELLING

SOLAR EYE DIAGRAMS


SCALE: NTS @ A3 DATE: 24.05.2022

ISSUE: H - Amendment - LEC


THIS DOCUMENT IS THE COPYRIGHT OF BJB ARCHITECTS.  
ALL INFORMATION ILLUSTRATED ON THIS DOCUMENT IS  
TO BE CHECKED AND VERIFIED ON SITE.  
IN THE EVENT OF DISCREPANCIES REFER TO BJB  
ARCHITECTS PRIOR TO COMMENCEMENT OF THE WORK.  
DO NOT SCALE DRAWINGS MANUALLY OR  
ELECTRONICALLY.

2020-031


A1502

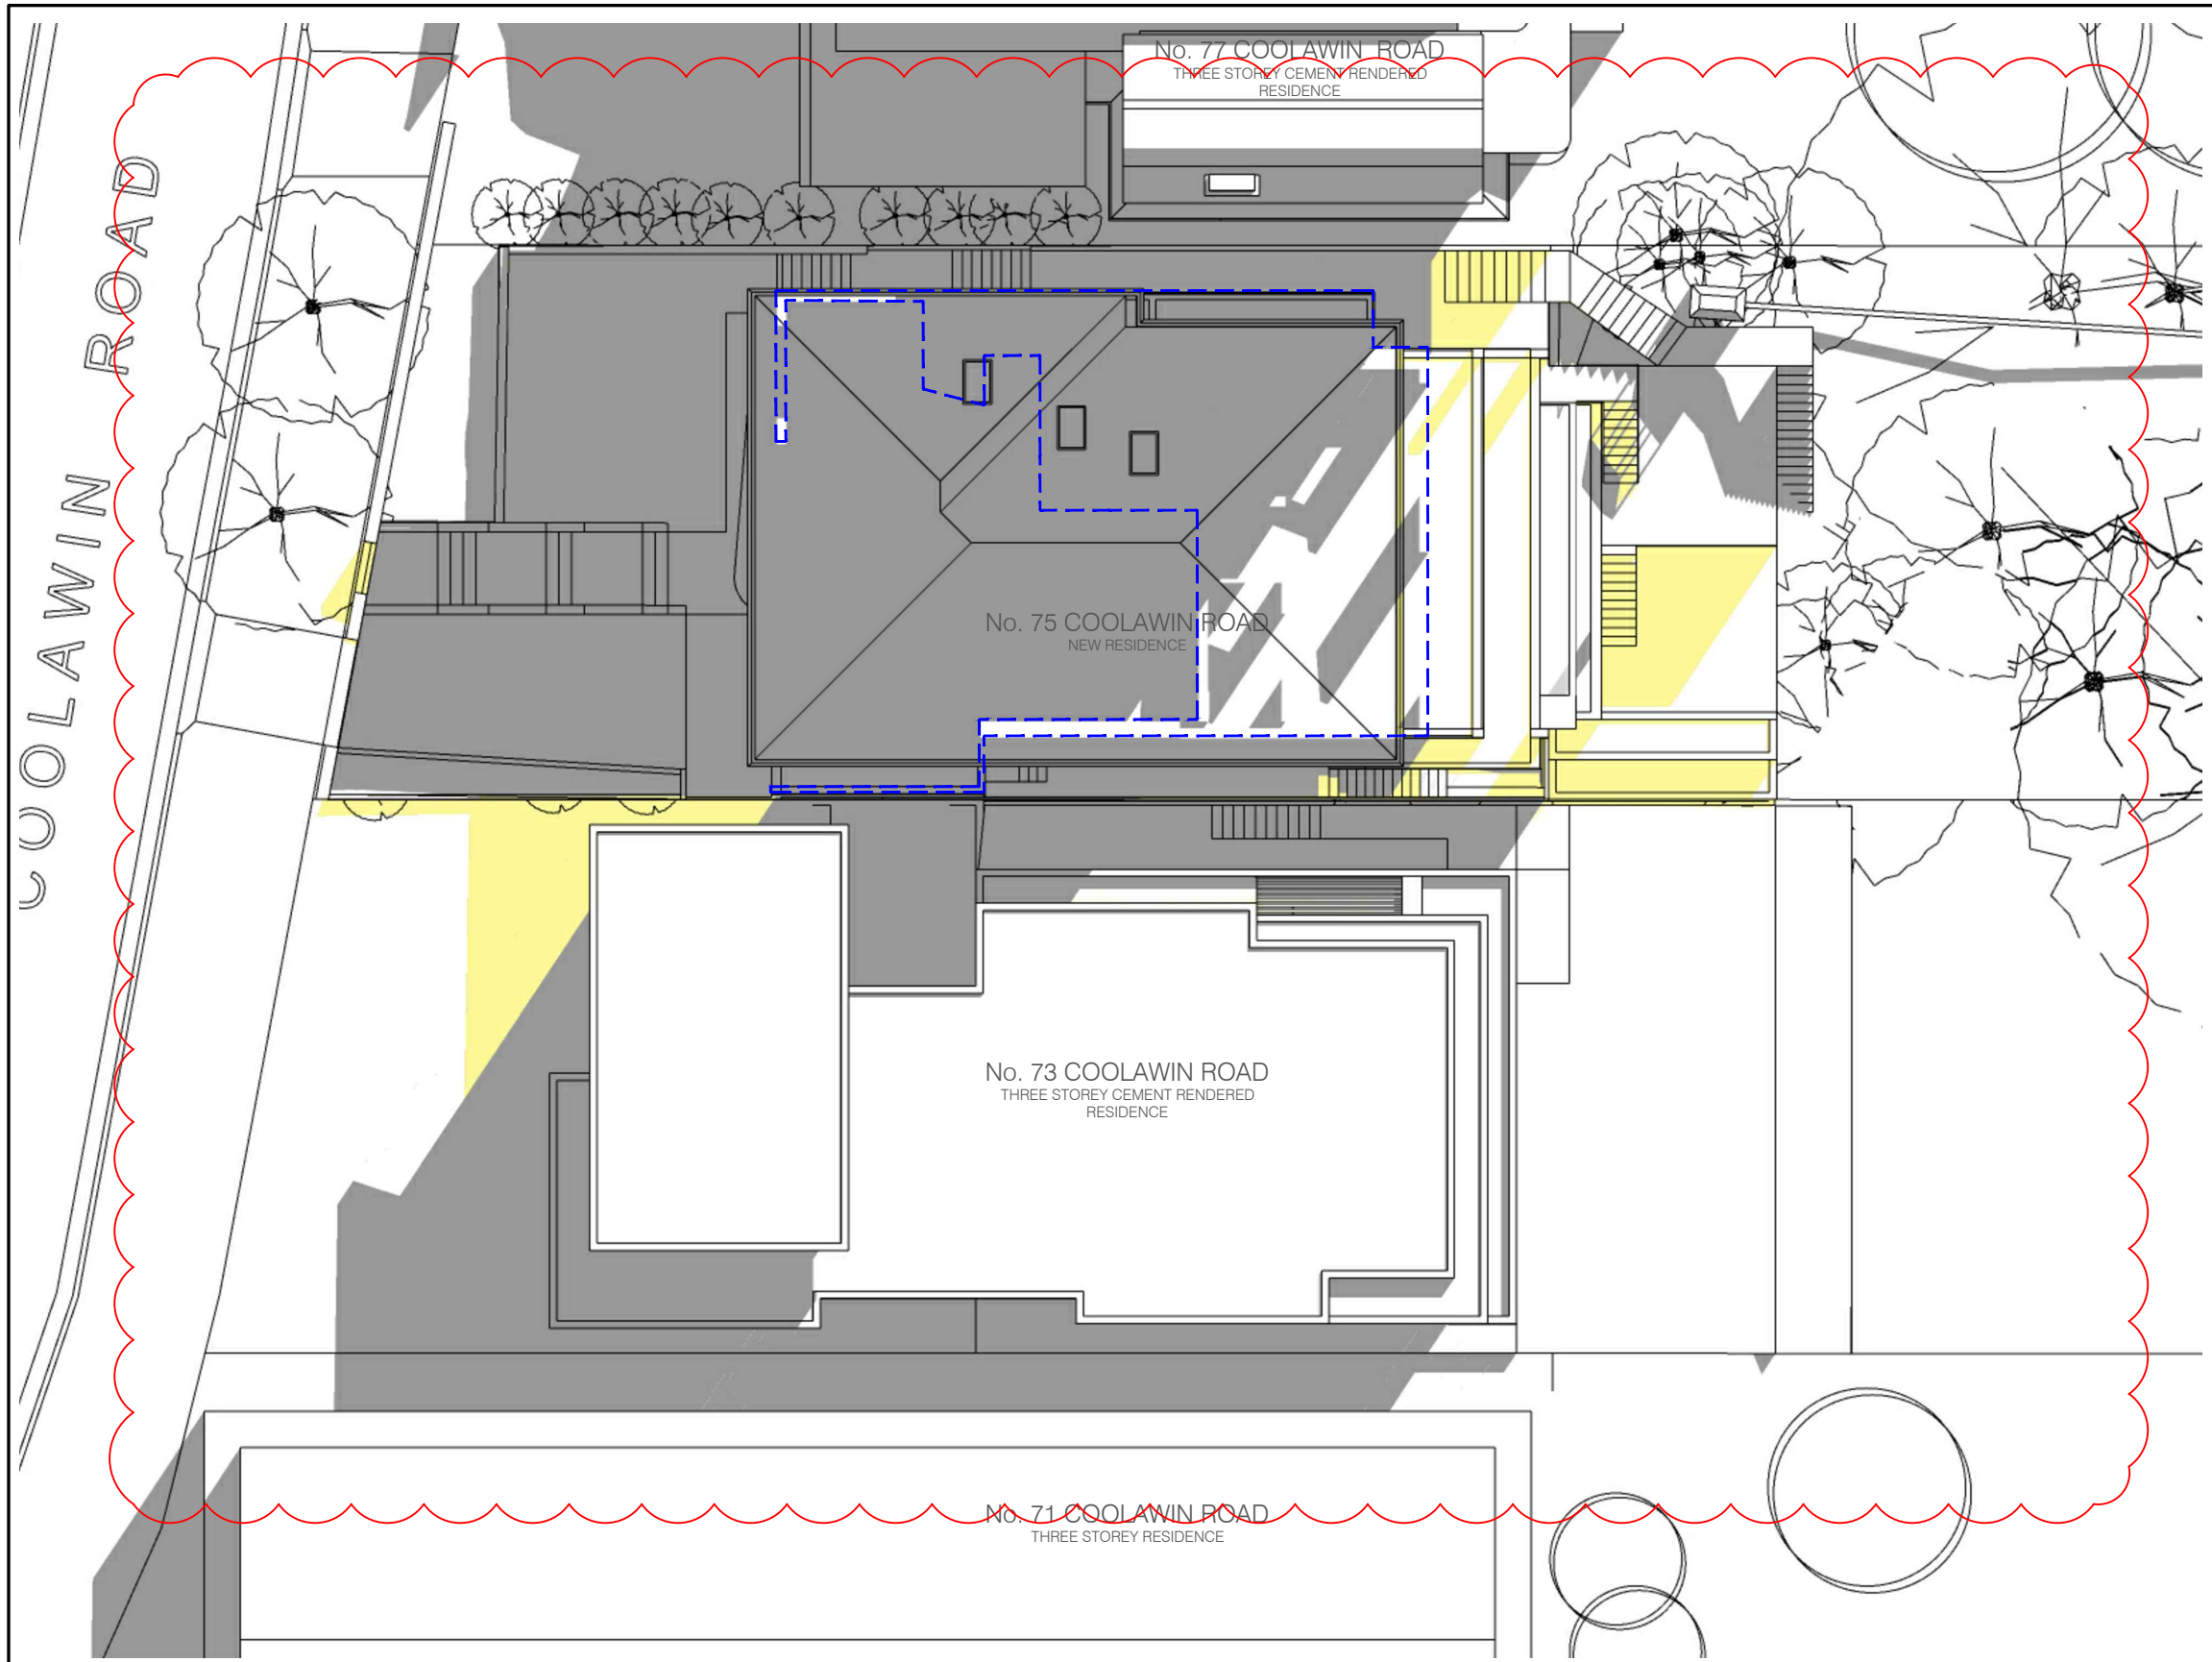


WINTER SOLSTICE – 22ND. JUNE		
9AM 43 DEGREES NE	12PM 0 DEGREES N	3PM 43 DEGREES NW
EQUINOX – 21ST. MARCH & SEPTEMBER		
9AM 60 DEGREES ENE	12PM 0 DEGREES N	3PM 60 DEGREES WNW
SUMMER SOLSTICE – 22ND. DECEMBER		
9AM 0 DEGREES E	12PM 0 DEGREES N	3PM 90 DEGREES W

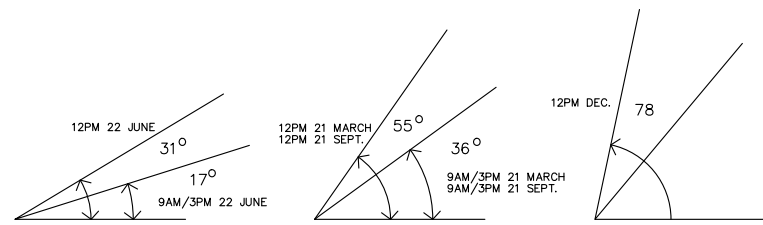

VERTICAL SUN ANGLES  
FOR SYDNEY – LATITUDE 35 DEGREES SOUTH

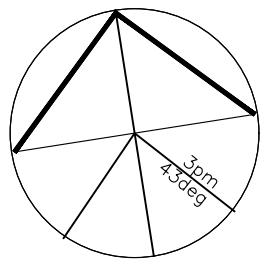

WINTER SOLSTICE – 22ND. JUNE

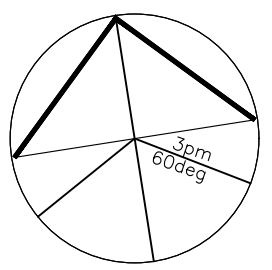

EQUINOX – 21ST. MARCH & SEPTEMBER

S H A D O W   D I A G R A M S   -   W I N T E R   S O L S T I C E   -   2 2 n d   J U N E   9 A M

ARCHITECT



t: 02 8970 5417  
e: studio@bjbarchitects.com.au  
a: 3.09/77 Dunning Ave  
Rosebery NSW 2018  
  
BJB Architects Pty Ltd  
Nominated Architect:  
Barry Babikian NSW Reg No 8806

LEGEND:

 EXISTING SHADOWS

 EXISTING LOWER GROUND FLOOR

 PROPOSED SHADOWS



ISSUE	AMENDMENT	DATE
E	Development Application	13.10.2020
F	DA Amendment	12.04.2021
G	Amendment - LEC	10.05.2022
H	Amendment - LEC	24.05.2022

PROJECT

75 COOLAWIN ROAD,  
NORTHBRIDGE  
NEW DWELLING

SHADOW DIAGRAMS

SCALE: 1:200 @ A3      DATE: 24.05.2022


ISSUE: H - Amendment - LEC

THIS DOCUMENT IS THE COPYRIGHT OF BJB ARCHITECTS. ALL INFORMATION ILLUSTRATED ON THIS DOCUMENT IS TO BE CHECKED AND VERIFIED ON SITE. IN THE EVENT OF DISCREPANCIES REFER TO BJB ARCHITECTS PRIOR TO COMMENCEMENT OF THE WORK. DO NOT SCALE DRAWINGS MANUALLY OR ELECTRONICALLY.


2020-031

A1511




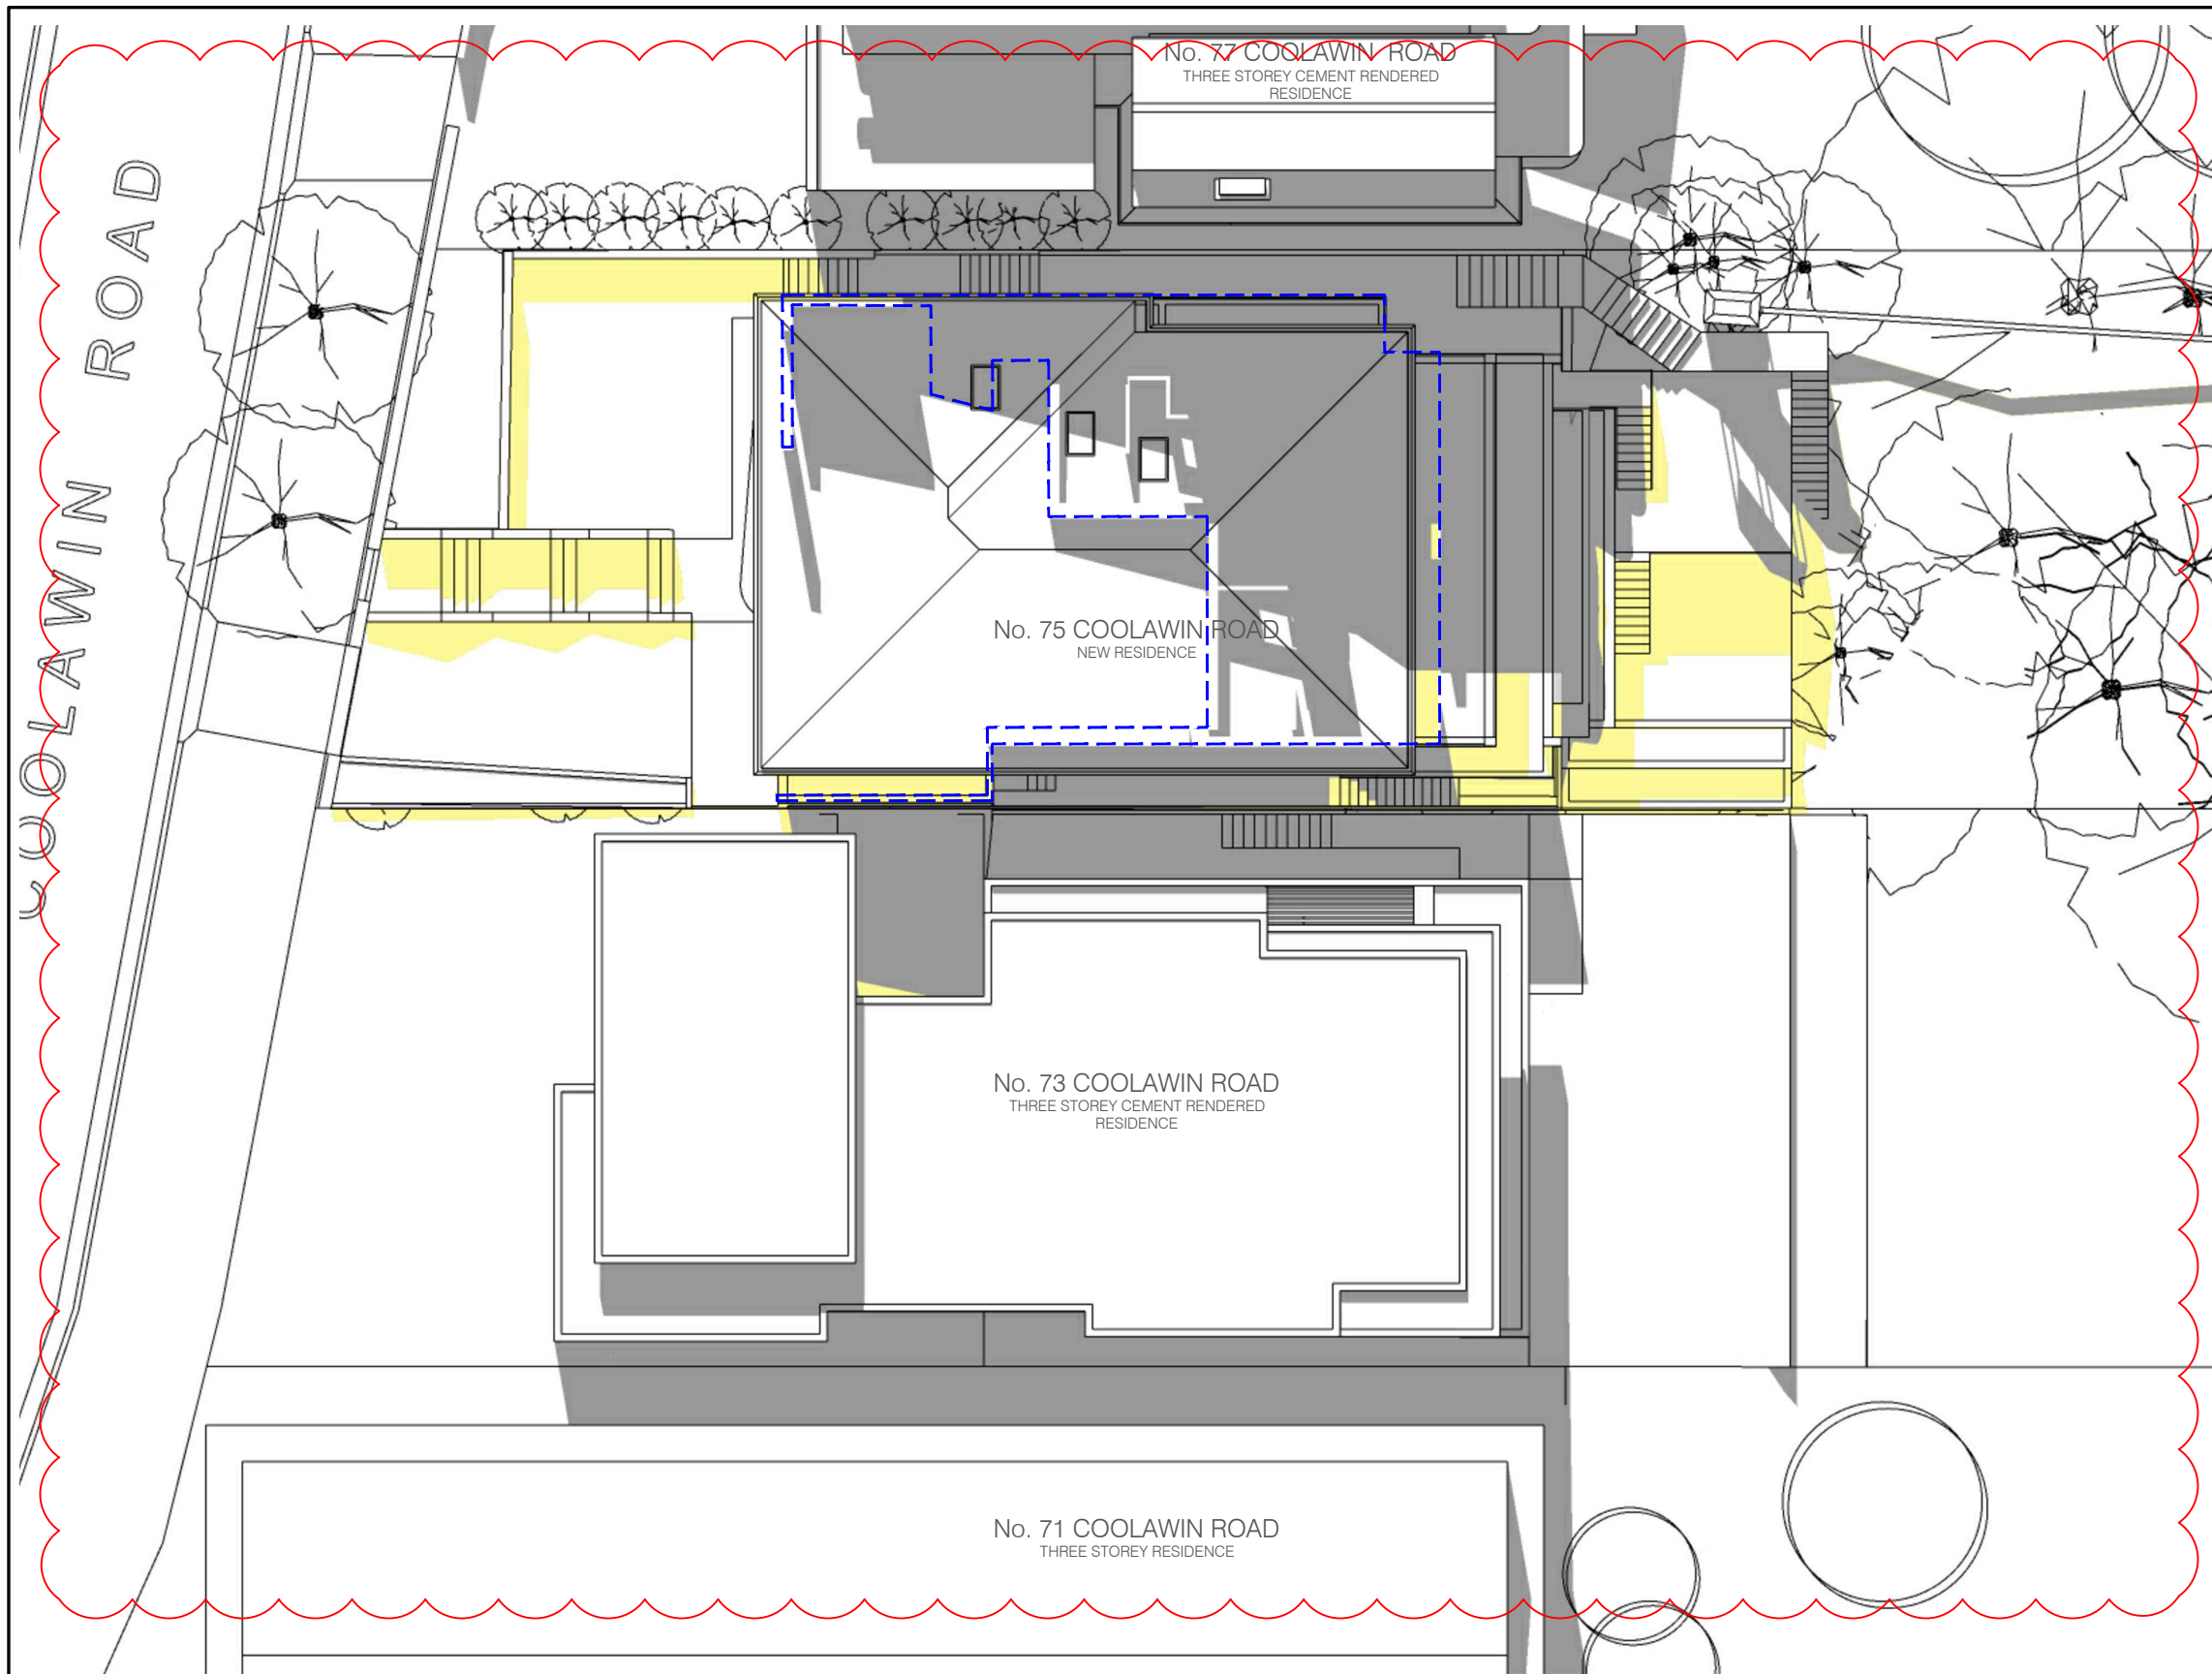


WINTER SOLSTICE – 22ND. JUNE		
9AM 43 DEGREES NE	12PM 0 DEGREES N	3PM 43 DEGREES NW
EQUINOX – 21ST. MARCH & SEPTEMBER		
9AM 60 DEGREES ENE	12PM 0 DEGREES N	3PM 60 DEGREES WNW
SUMMER SOLSTICE – 22ND. DECEMBER		
9AM 0 DEGREES E	12PM 0 DEGREES N	3PM 90 DEGREES W

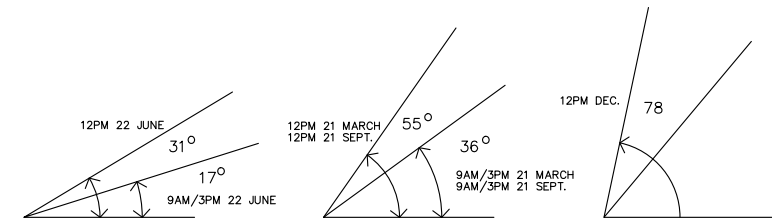

VERTICAL SUN ANGLES  
FOR SYDNEY – LATITUDE 35 DEGREES SOUTH

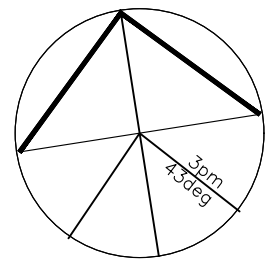


WINTER SOLSTICE – 22ND. JUNE

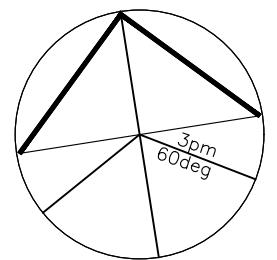

EQUINOX – 21ST. MARCH & SEPTEMBER

# SHADOW DIAGRAMS - WINTER SOLSTICE - 22nd JUNE 12 PM

## ARCHITECT

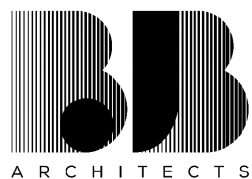

t: 02 8970 5417  
e: studio@bjbarchitects.com.au  
a: 3.09/77 Dunning Ave  
Rosebery NSW 2018

BBJ Architects Pty Ltd  
Nominated Architect:  
Barry Babikian NSW Reg No 8806

## LEGEND:




EXISTING SHADOWS



EXISTING LOWER  
GROUND FLOOR



PROPOSED SHADOWS

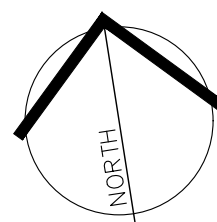

ISSUE	AMENDMENT	DATE
E	Development Application	13.10.2020
F	DA Amendment	12.04.2021
G	Amendment - LEC	10.05.2022
H	Amendment - LEC	24.05.2022

## PROJECT

75 COOLAWIN ROAD,  
NORTHBRIDGE  
NEW DWELLING

## SHADOW DIAGRAMS


SCALE: 1:200 @ A3      DATE: 24.05.2022

ISSUE: H - Amendment - LEC


THIS DOCUMENT IS THE COPYRIGHT OF BJB ARCHITECTS.  
ALL INFORMATION ILLUSTRATED ON THIS DOCUMENT IS  
TO BE CHECKED AND VERIFIED ON SITE.  
IN THE EVENT OF DISCREPANCIES REFER TO BJB  
ARCHITECTS PRIOR TO COMMENCEMENT OF THE WORK.  
DO NOT SCALE DRAWINGS MANUALLY OR  
ELECTRONICALLY.

2020-031


A1512

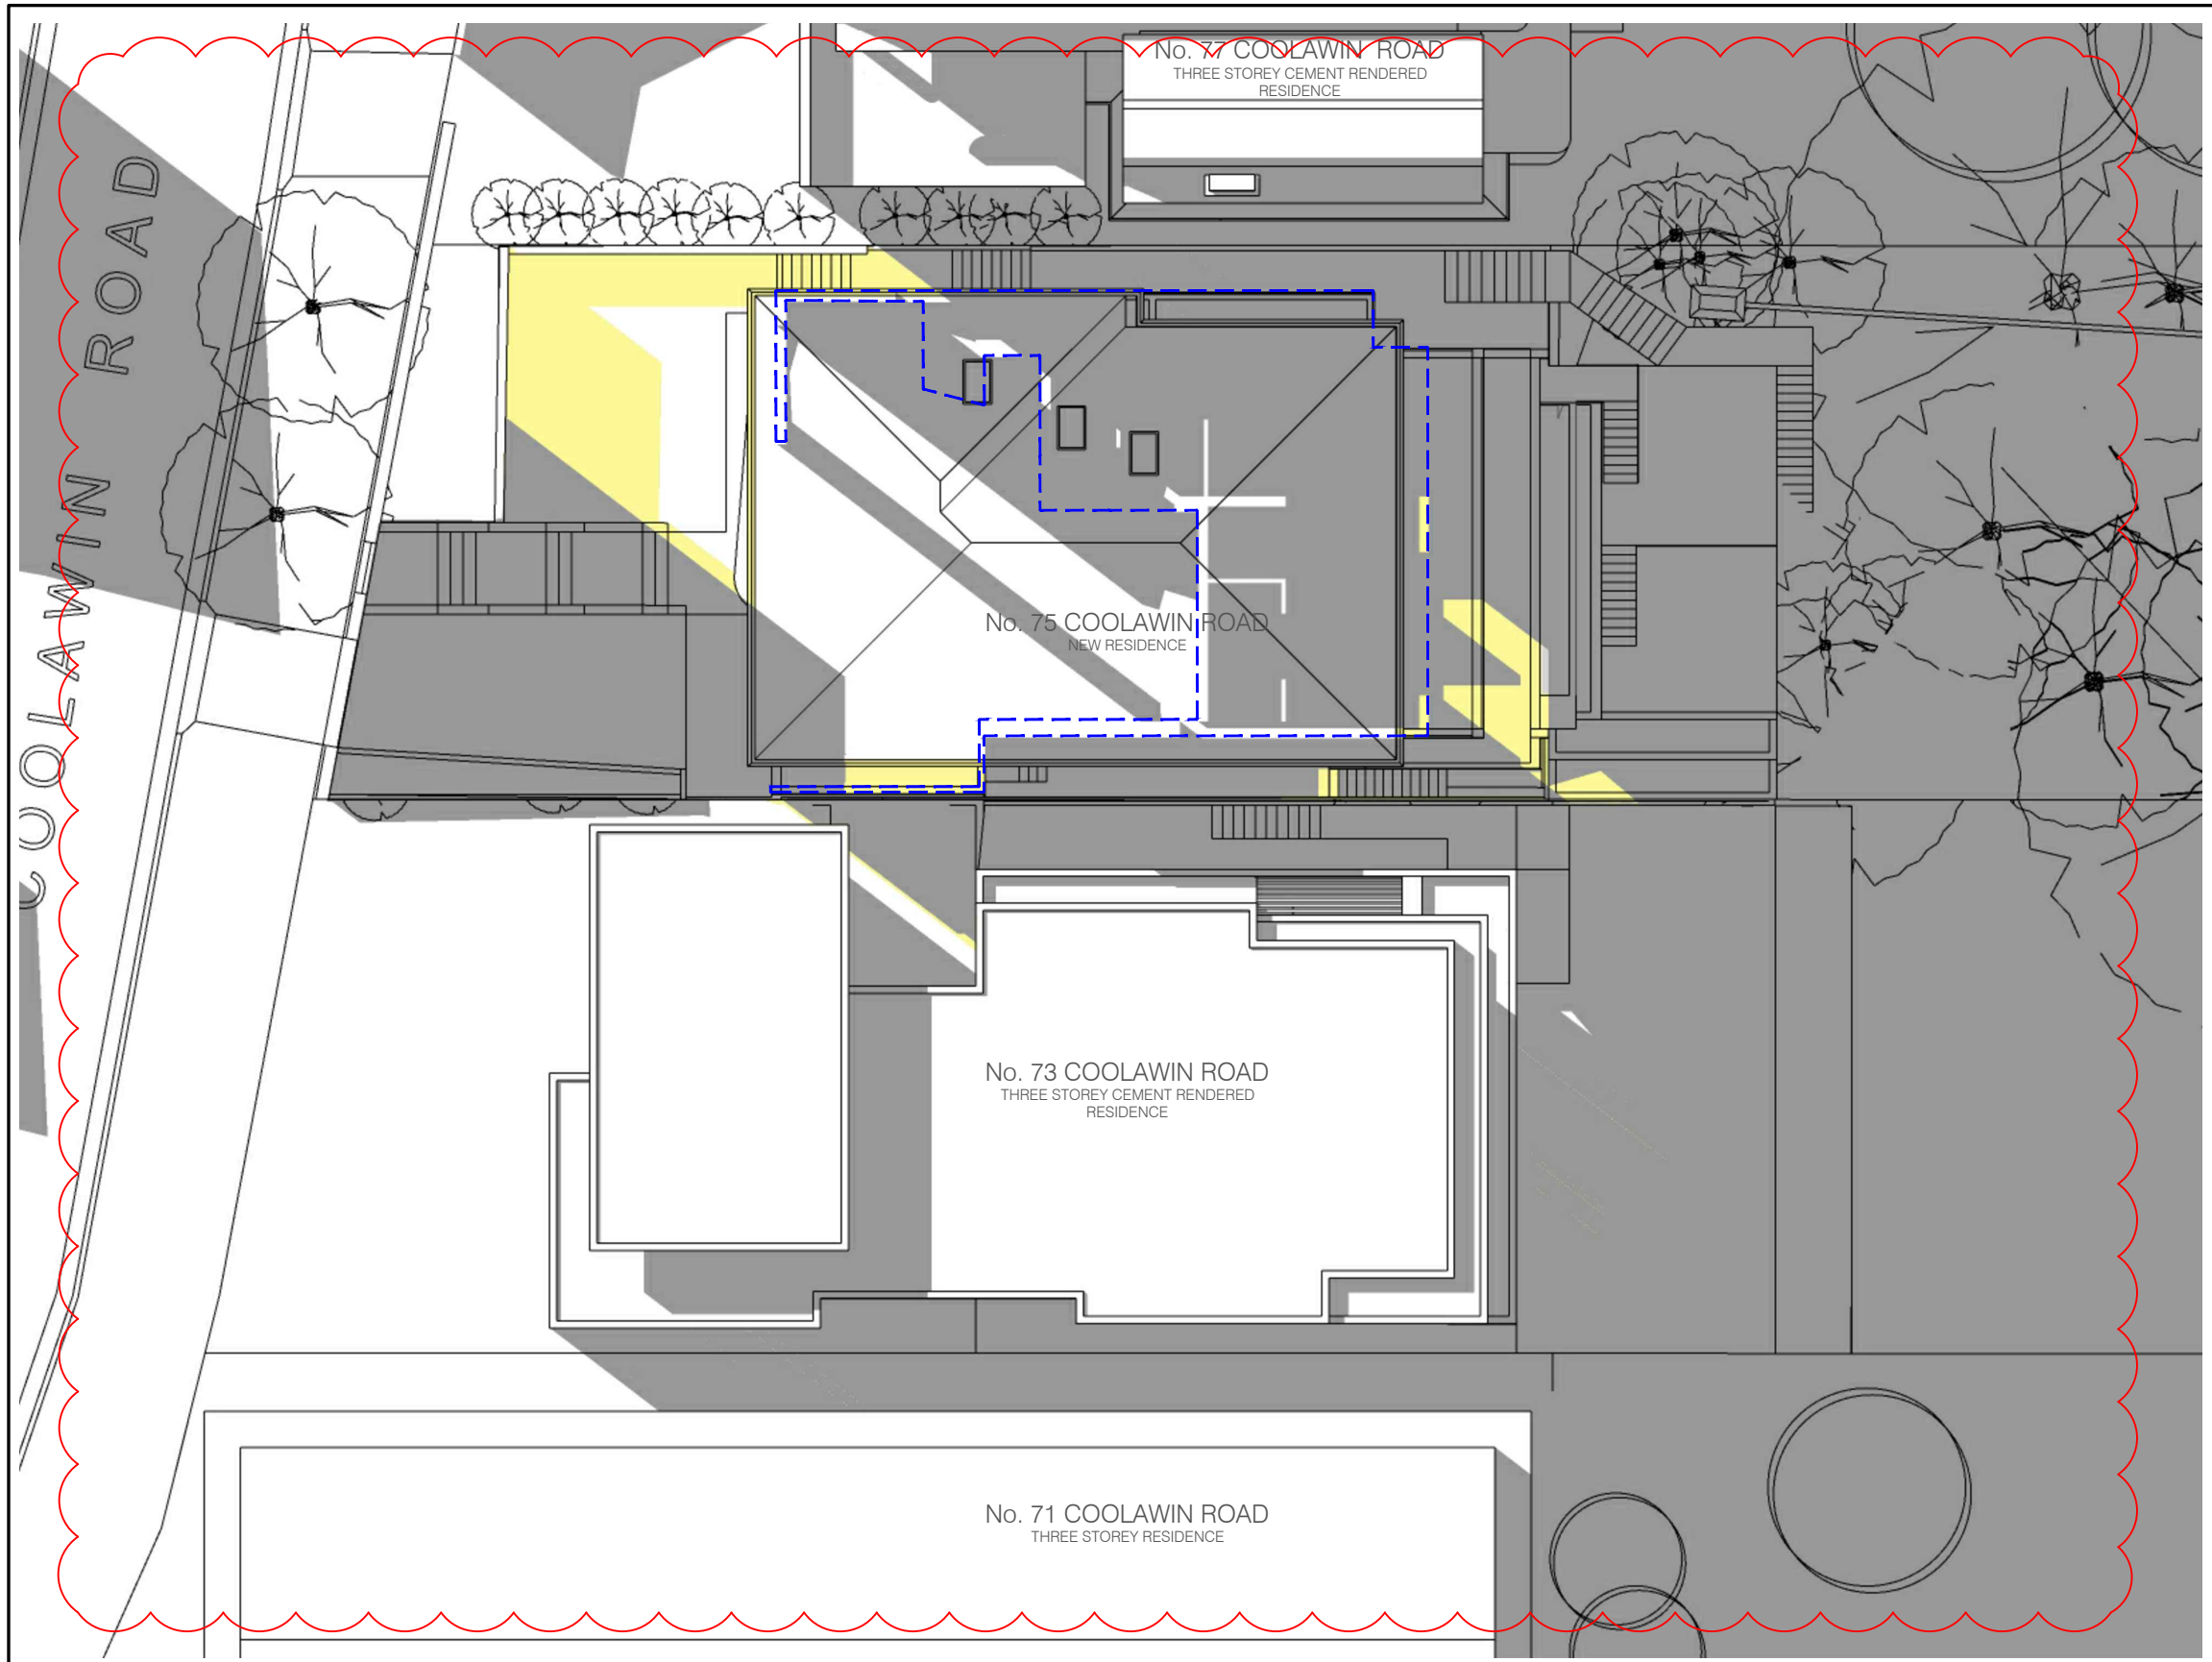


WINTER SOLSTICE – 22ND. JUNE		
9AM 43 DEGREES NE	12PM 0 DEGREES N	3PM 43 DEGREES NW
EQUINOX – 21ST. MARCH & SEPTEMBER		
9AM 60 DEGREES ENE	12PM 0 DEGREES N	3PM 60 DEGREES WNW
SUMMER SOLSTICE – 22ND. DECEMBER		
9AM 0 DEGREES E	12PM 0 DEGREES N	3PM 90 DEGREES W

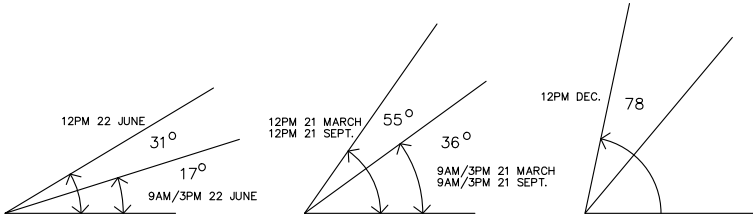

VERTICAL SUN ANGLES  
FOR SYDNEY – LATITUDE 35 DEGREES SOUTH

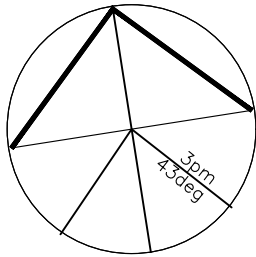

WINTER SOLSTICE – 22ND. JUNE

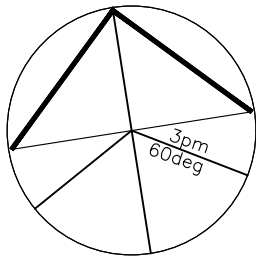

EQUINOX – 21ST. MARCH & SEPTEMBER

S H A D O W   D I A G R A M S   -   W I N T E R   S O L S T I C E   -   2 2 n d   J U N E   3 P M


ARCHITECT





t: 02 8970 5417  
e: studio@bjbarchitects.com.au  
a: 3.09/77 Dunning Ave  
Rosebery NSW 2018


BBJ Architects Pty Ltd  
Nominated Architect:  
Barry Babikian NSW Reg No 8806

LEGEND:

 EXISTING SHADOWS

 EXISTING LOWER GROUND FLOOR

 PROPOSED SHADOWS

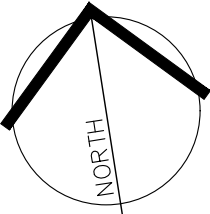

ISSUE	AMENDMENT	DATE
E	Development Application	13.10.2020
F	DA Amendment	12.04.2021
G	Amendment - LEC	10.05.2022
H	Amendment - LEC	24.05.2022

PROJECT

75 COOLAWIN ROAD,  
NORTHBRIDGE

NEW DWELLING

SHADOW DIAGRAMS

SCALE: 1:200 @ A3      DATE: 24.05.2022



ISSUE: H - Amendment - LEC

THIS DOCUMENT IS THE COPYRIGHT OF BJB ARCHITECTS. ALL INFORMATION ILLUSTRATED ON THIS DOCUMENT IS TO BE CHECKED AND VERIFIED ON SITE. IN THE EVENT OF DISCREPANCIES REFER TO BJB ARCHITECTS PRIOR TO COMMENCEMENT OF THE WORK. DO NOT SCALE DRAWINGS MANUALLY OR ELECTRONICALLY.

2020-031

A1513



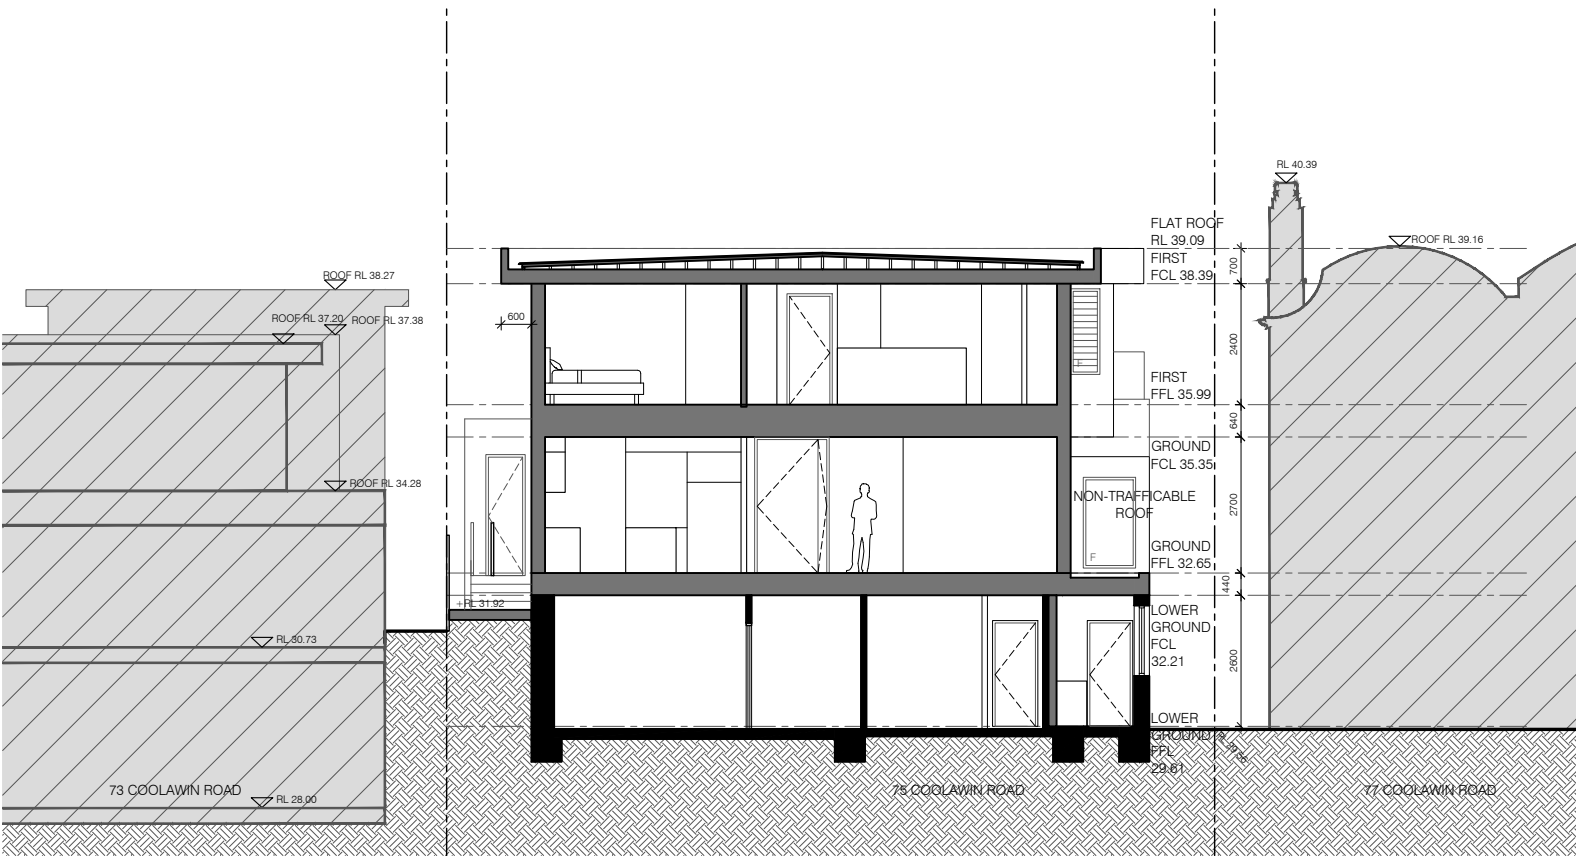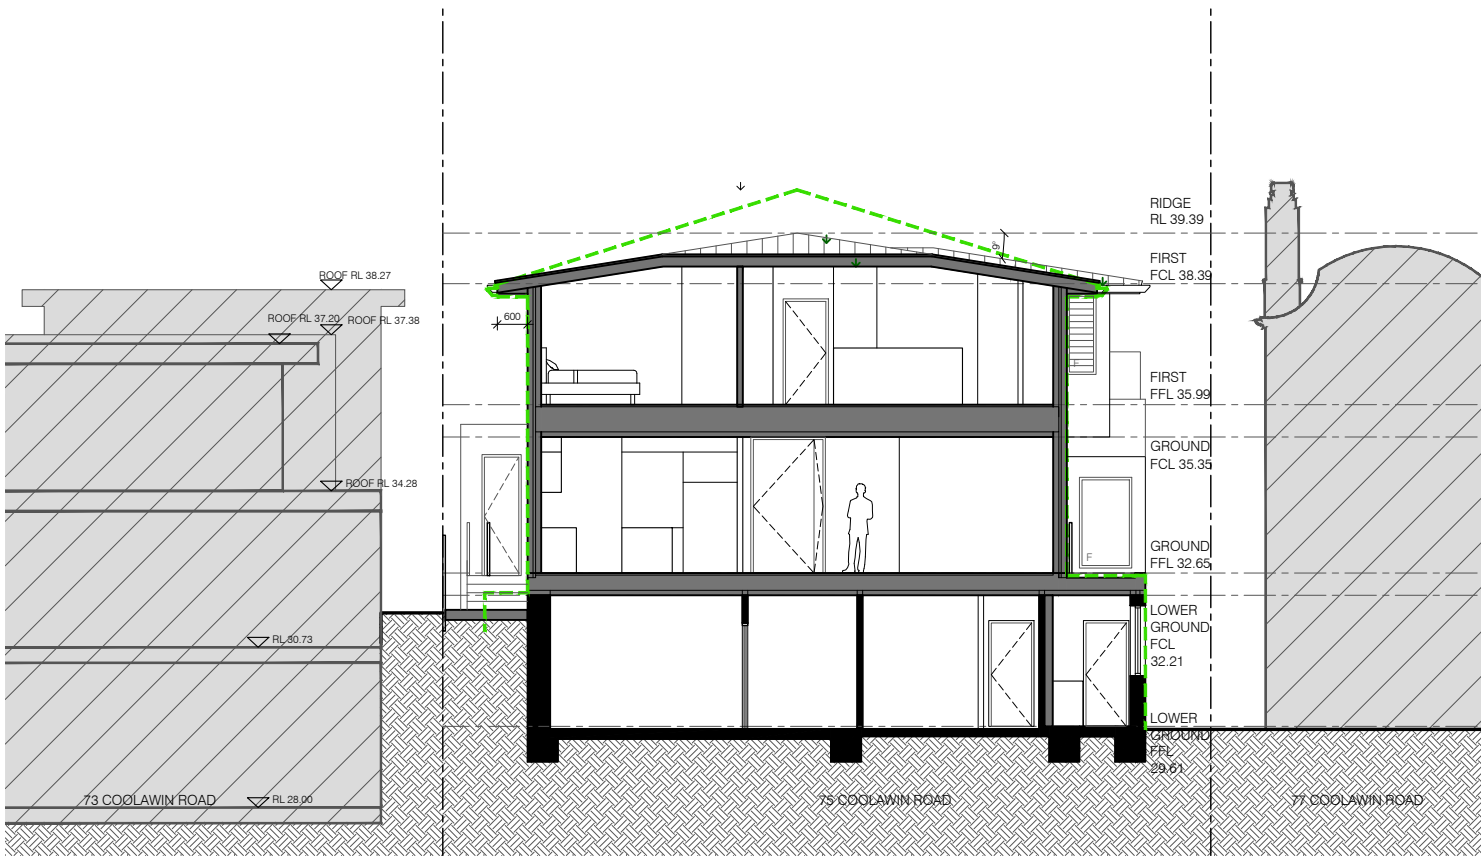

PROPOSED: PITCHED ROOF

ALTERNATE: FLAT ROOF

ARCHITECT

**B B**

t: 02 8970 5417  
e: studio@bjbarchitects.com.au  
a: 3.09/77 Dunning Ave  
Rosebery NSW 2018

BJB Architects Pty Ltd  
Nominated Architect:  
Barry Babikian NSW Reg No 8806

LEGEND

- EXISTING STRUCTURE
- NEW STRUCTURE
- PROPOSED AREA OF WORKS
- PREVIOUS DA SUBMISSION

ISSUE	AMENDMENT	DATE
E	Development Application	13.10.2020
F	DA Amendment	12.04.2021
G	Amendment - LEC	10.05.2022
H	Amendment - LEC	24.05.2022

PROJECT

**75 COOLAWIN ROAD,  
NORTHBRIDGE**

NEW DWELLING

FLAT ROOF - 3D & SECTIONS

SCALE: 1:150 @ A3 DATE: 24.05.2022



ISSUE: H - Amendment - LEC

THIS DOCUMENT IS THE COPYRIGHT OF BJB ARCHITECTS. ALL INFORMATION ILLUSTRATED ON THIS DOCUMENT IS TO BE CHECKED AND VERIFIED ON SITE. IN THE EVENT OF DISCREPANCIES REFER TO BJB ARCHITECTS PRIOR TO COMMENCEMENT OF THE WORK. DO NOT SCALE DRAWINGS MANUALLY OR ELECTRONICALLY.

2020-031

**A2001**



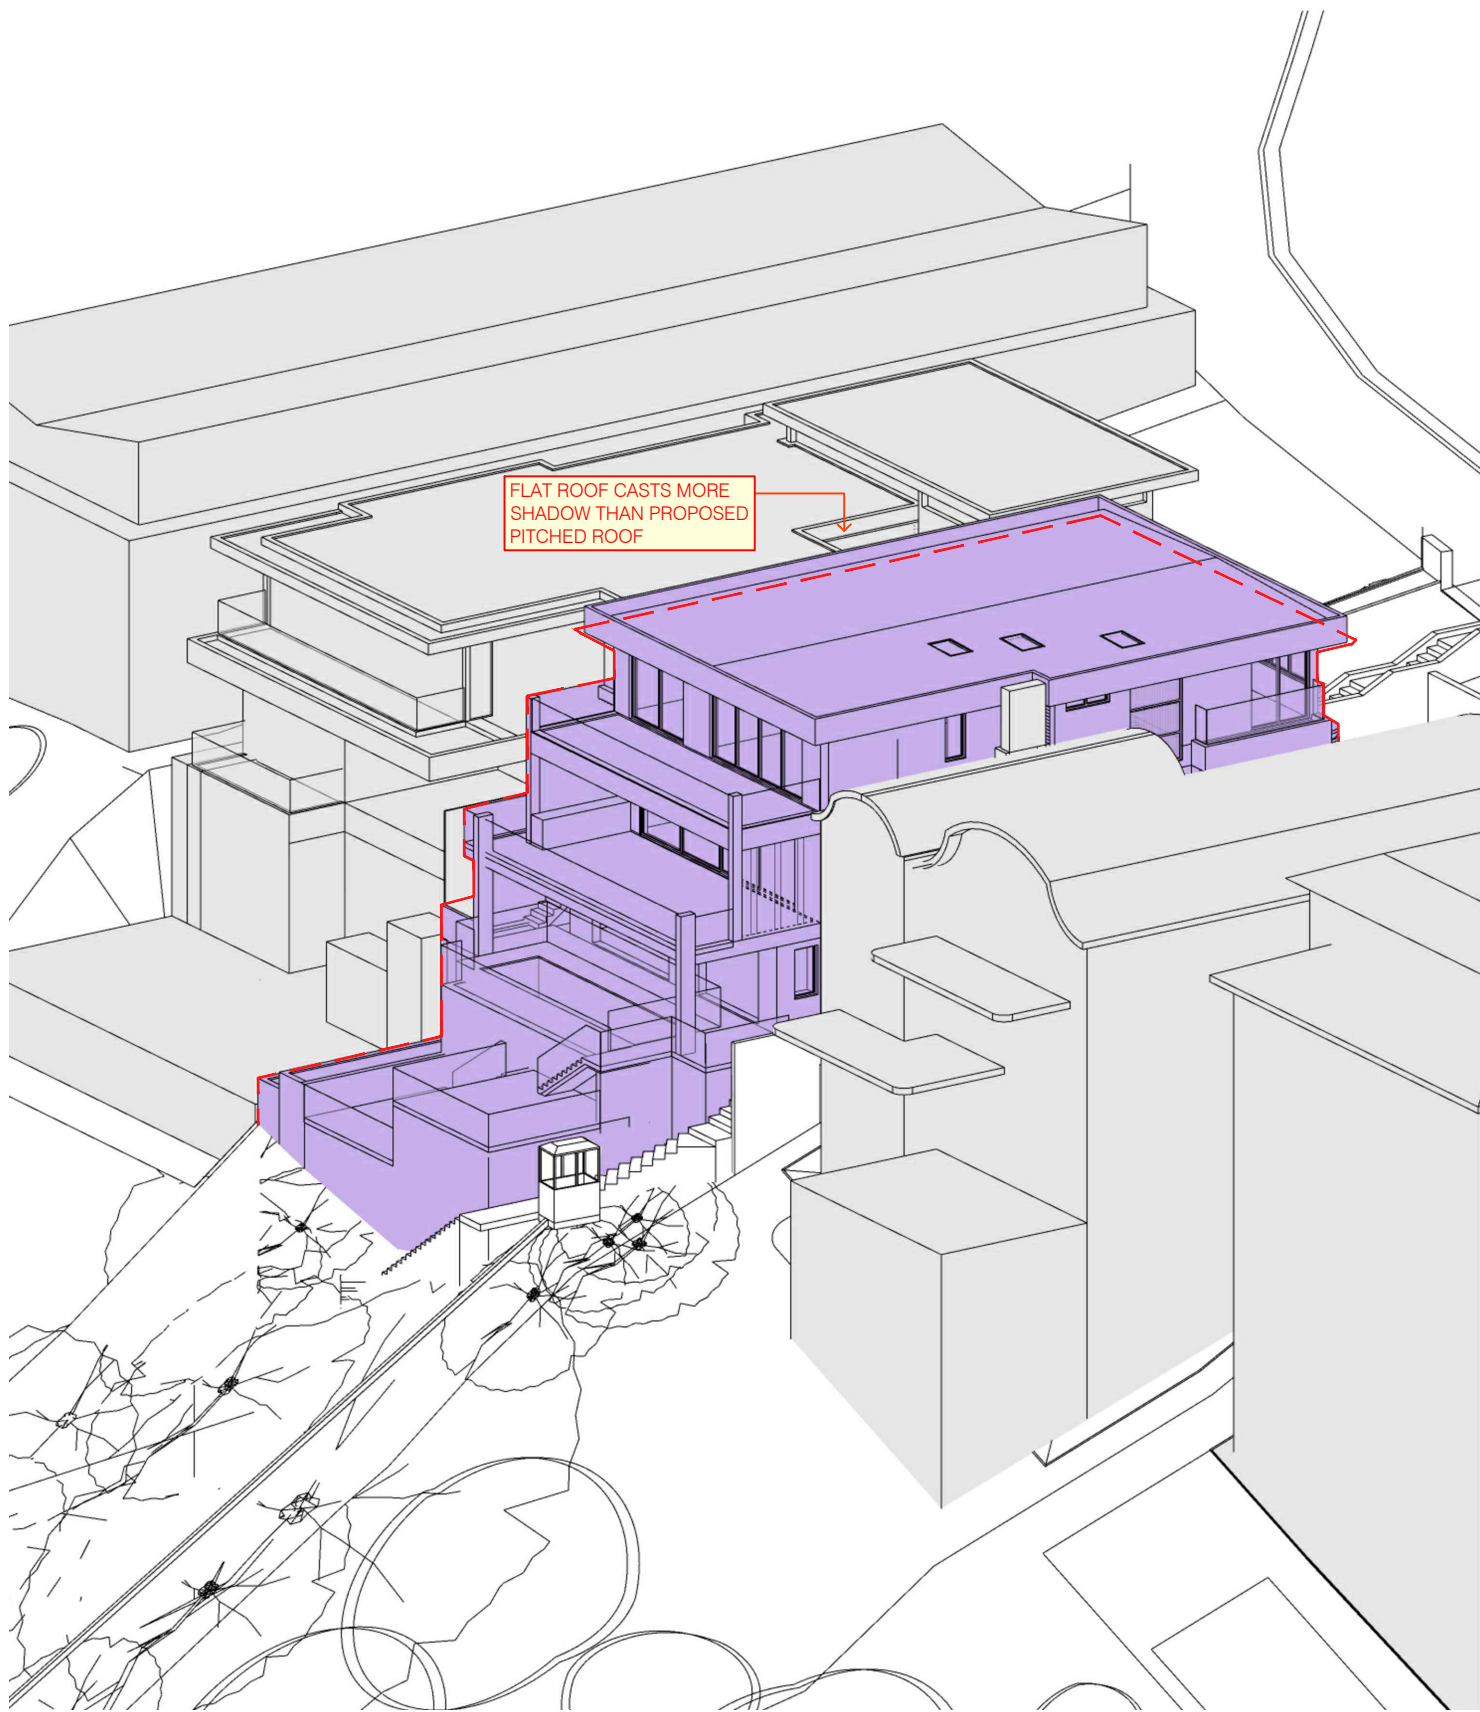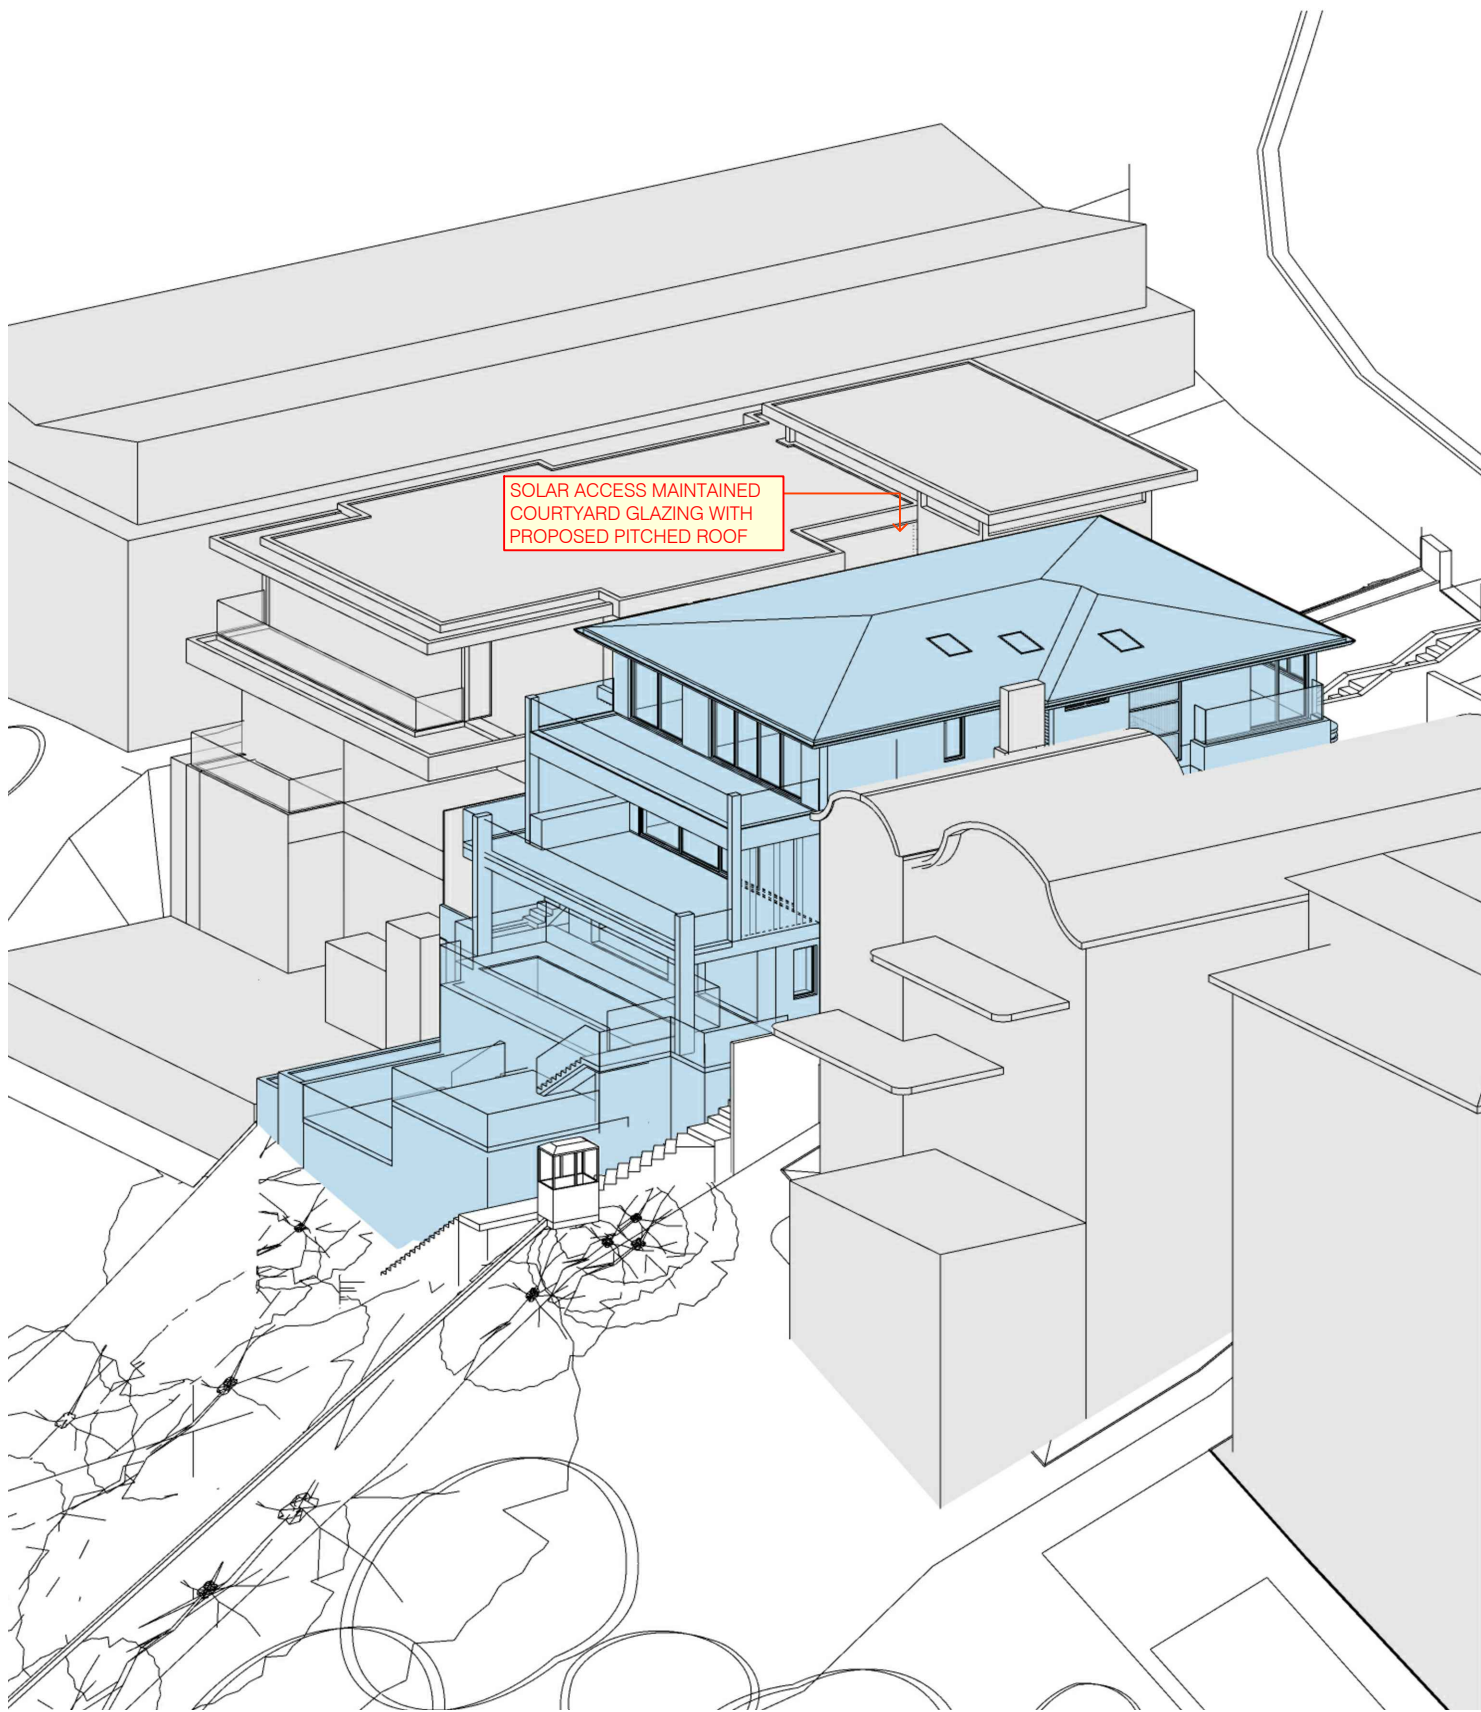

PROPOSED: PITCHED ROOF  
SHADOW DIAGRAMS - WINTER SOLSTICE - 22nd JUNE 9 AM

ALTERNATE: FLAT ROOF

ARCHITECT


**BB**


ARCHITECTS


t: 02 8970 5417  
e: studio@bjbarchitects.com.au  
a: 3.09/77 Dunning Ave  
Rosebery NSW 2018

BJB Architects Pty Ltd  
Nominated Architect:  
Barry Babikian NSW Reg No 8806

LEGEND:

 PROPOSED BUILDING

 RED DASHED LINE INDICATES  
EXTENT OF PROPOSED BUILDING/  
SHADOWS

 FLAT ROOF OPTION

ISSUE	AMENDMENT	DATE
E	Development Application	13.10.2020
F	DA Amendment	12.04.2021
G	Amendment - LEC	10.05.2022
H	Amendment - LEC	24.05.2022

PROJECT

**75 COOLAWIN ROAD,  
NORTHBRIDGE**

NEW DWELLING

FLAT ROOF - SOLAR EYE DIAGRAMS


SCALE: NTS @ A3      DATE: 24.05.2022

ISSUE: H - Amendment - LEC


THIS DOCUMENT IS THE COPYRIGHT OF BJB ARCHITECTS. ALL INFORMATION ILLUSTRATED ON THIS DOCUMENT IS TO BE CHECKED AND VERIFIED ON SITE. IN THE EVENT OF DISCREPANCIES REFER TO BJB ARCHITECTS PRIOR TO COMMENCEMENT OF THE WORK. DO NOT SCALE DRAWINGS MANUALLY OR ELECTRONICALLY.

2020-031

**A2011**

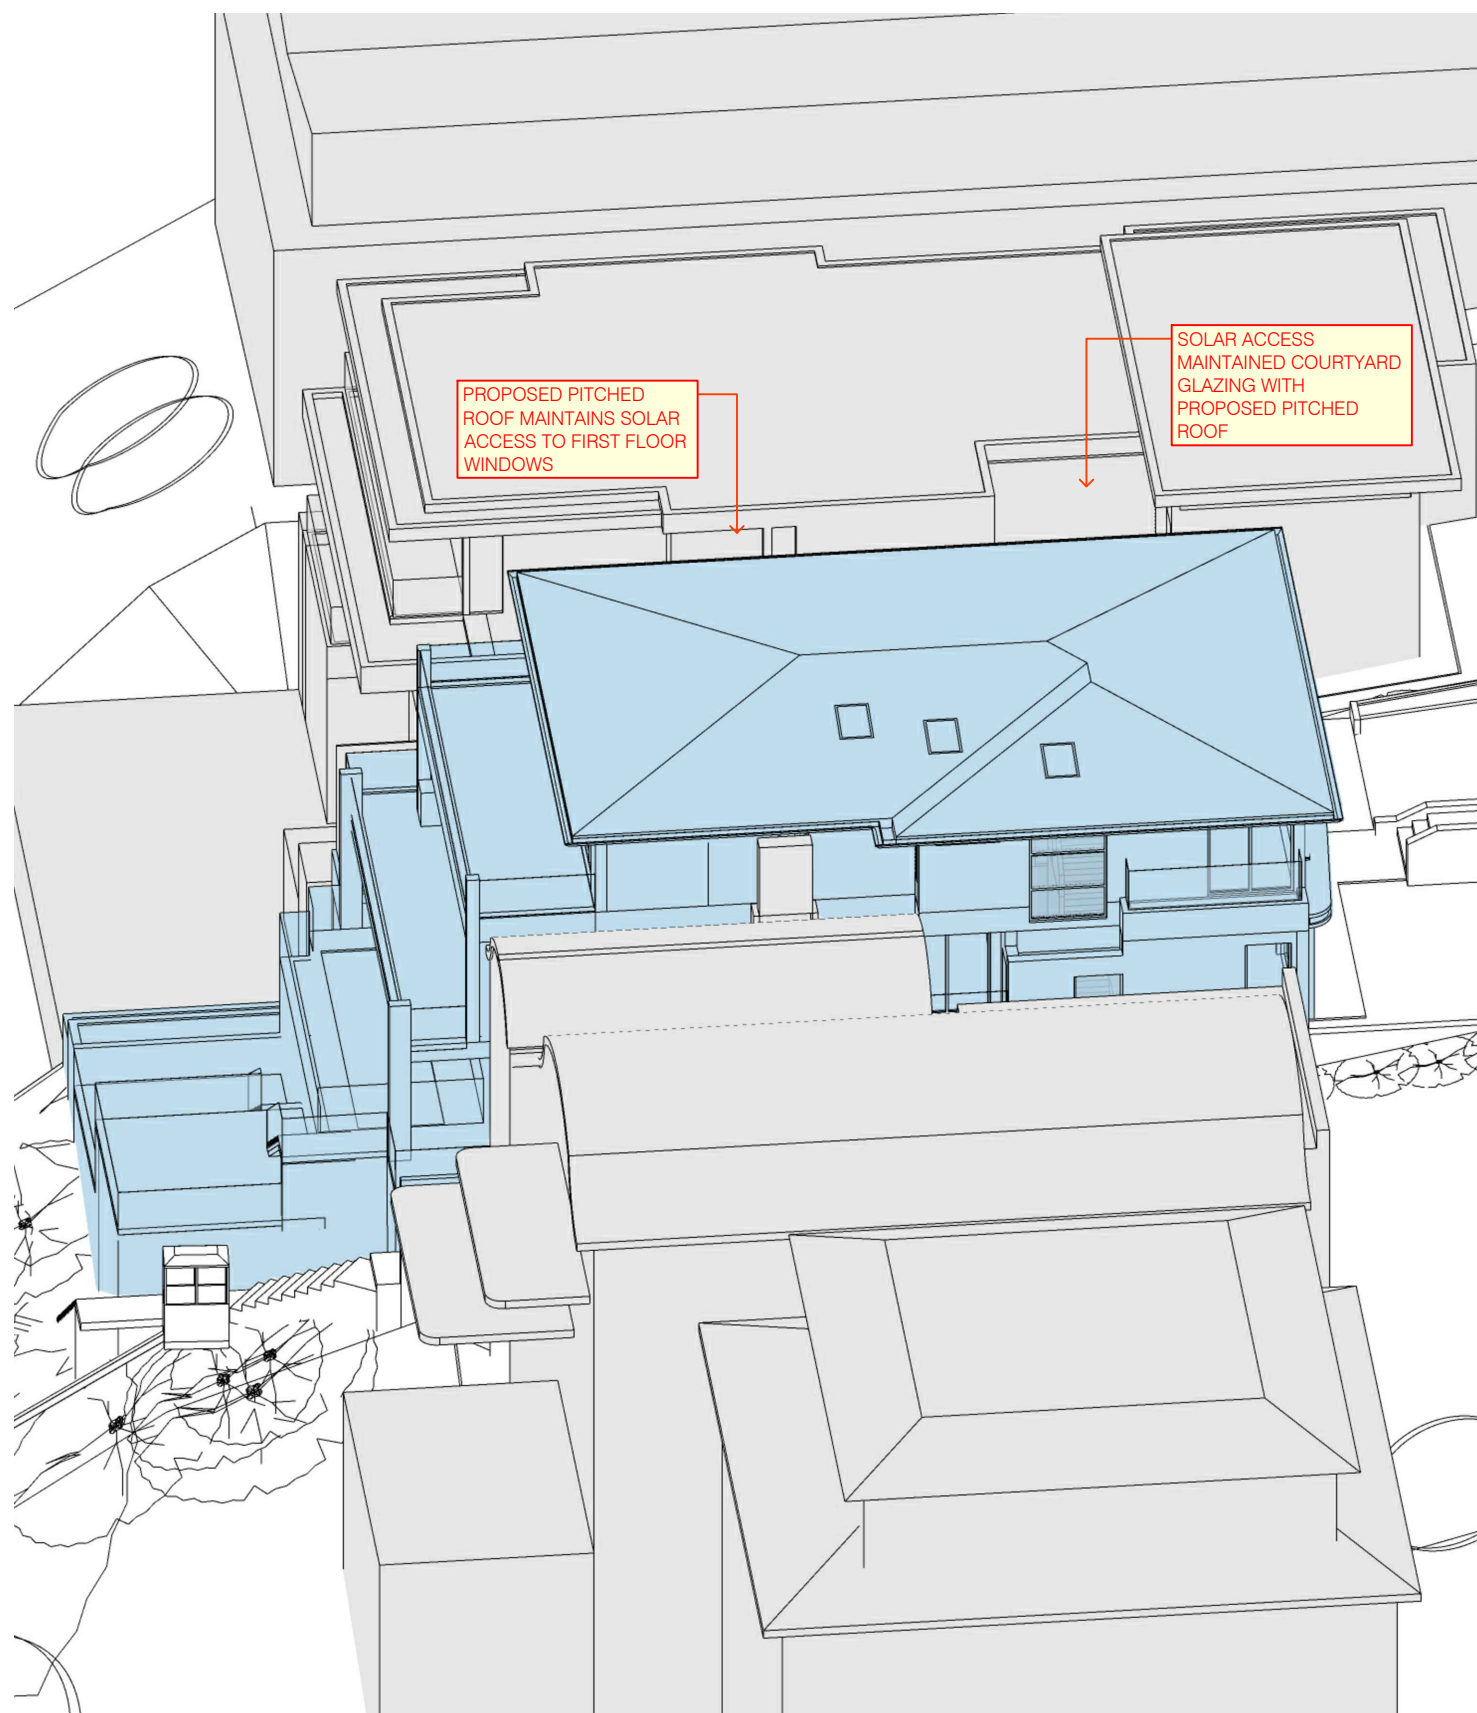

PROPOSED: PITCHED ROOF

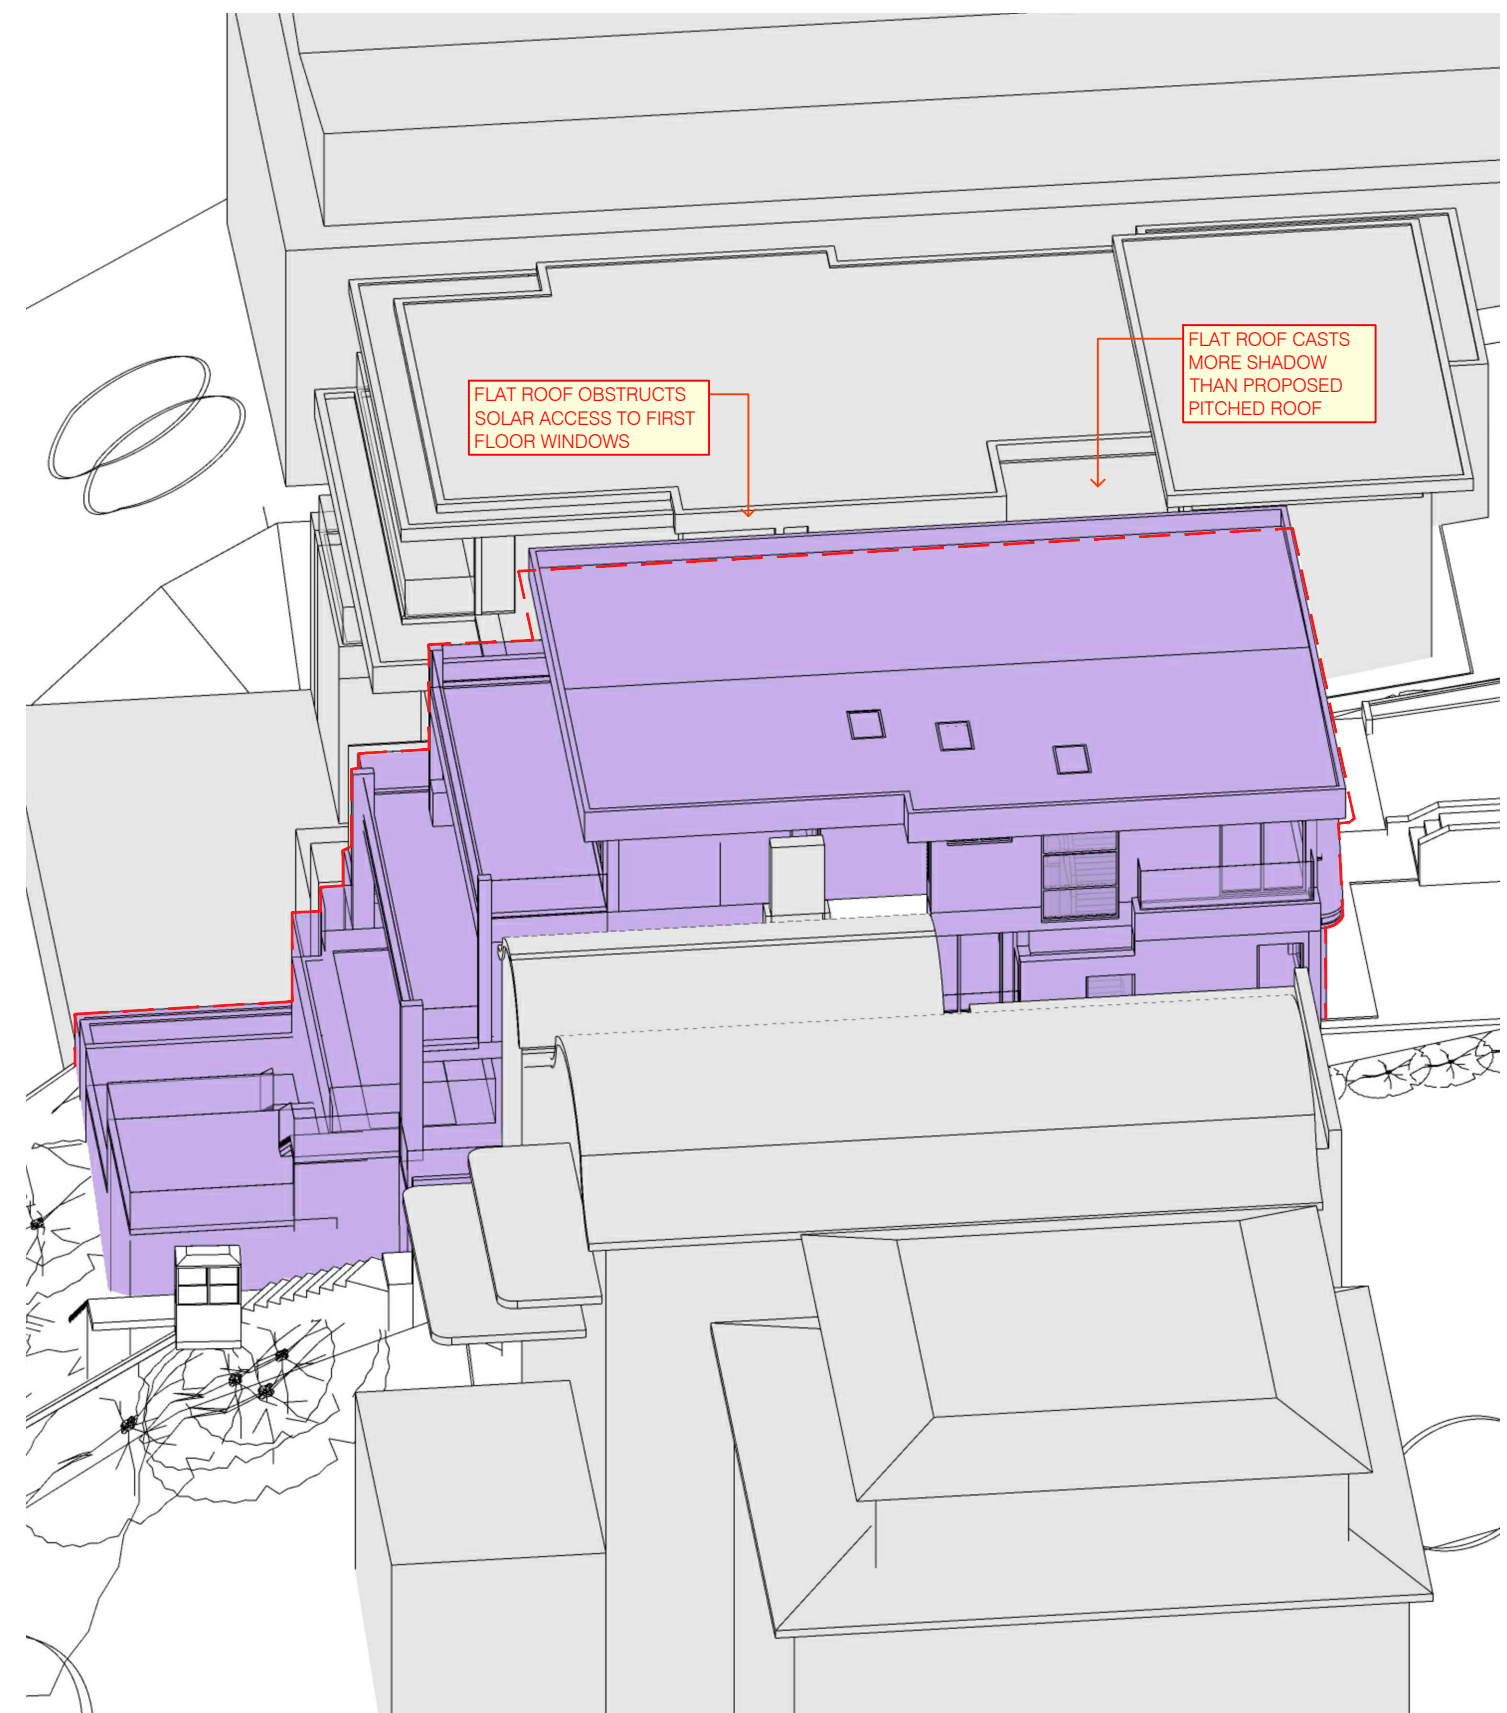

ALTERNATE: FLAT ROOF

S H A D O W   D I A G R A M S   -   W I N T E R   S O L S T I C E   -   2 2 n d   J U N E   1 1 A M

ARCHITECT



t: 02 8970 5417  
e: studio@bjbarchitects.com.au  
a: 3.09/77 Dunning Ave  
Rosebery NSW 2018

BJB Architects Pty Ltd  
Nominated Architect:  
Barry Babikian NSW Reg No 8806

LEGEND:



PROPOSED BUILDING



FLAT ROOF OPTION



RED DASHED LINE INDICATES  
EXTENT OF PROPOSED BUILDING/  
SHADOWS

ISSUE	AMENDMENT	DATE
E	Development Application	13.10.2020
F	DA Amendment	12.04.2021
G	Amendment - LEC	10.05.2022
H	Amendment - LEC	24.05.2022

PROJECT

75 COOLAWIN ROAD,  
NORTHBRIDGE  
NEW DWELLING

FLAT ROOF - SOLAR EYE DIAGRAMS

SCALE: NTS @ A3      DATE: 24.05.2022


ISSUE: H - Amendment - LEC

THIS DOCUMENT IS THE COPYRIGHT OF BJB ARCHITECTS.  
ALL INFORMATION ILLUSTRATED ON THIS DOCUMENT IS  
TO BE CHECKED AND VERIFIED ON SITE.  
IN THE EVENT OF DISCREPANCIES REFER TO BJB  
ARCHITECTS PRIOR TO COMMENCEMENT OF THE WORK.  
DO NOT SCALE DRAWINGS MANUALLY OR  
ELECTRONICALLY.


2020-031

A2012



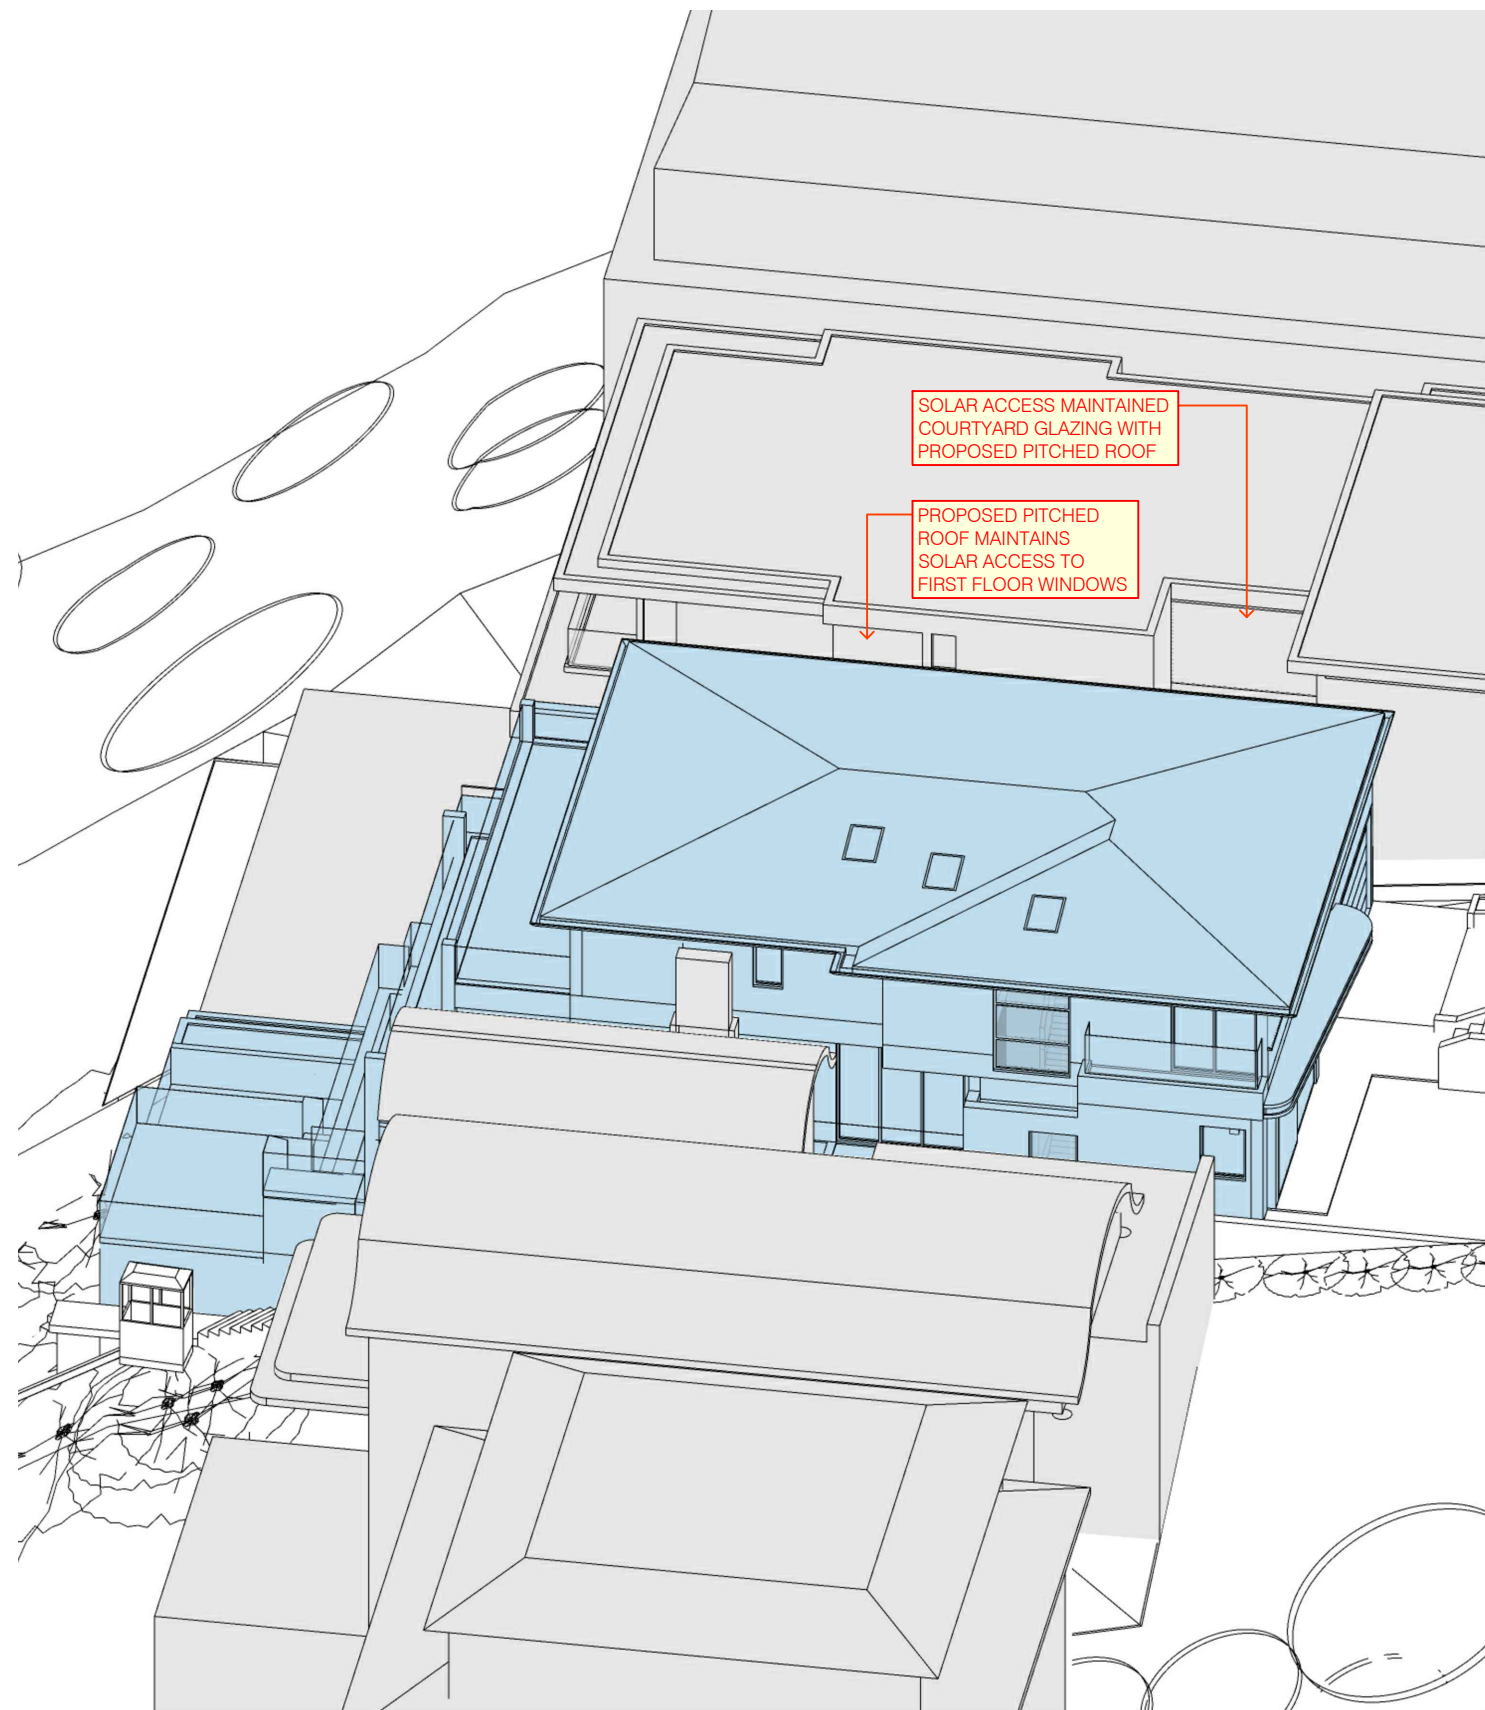

PROPOSED: PITCHED ROOF

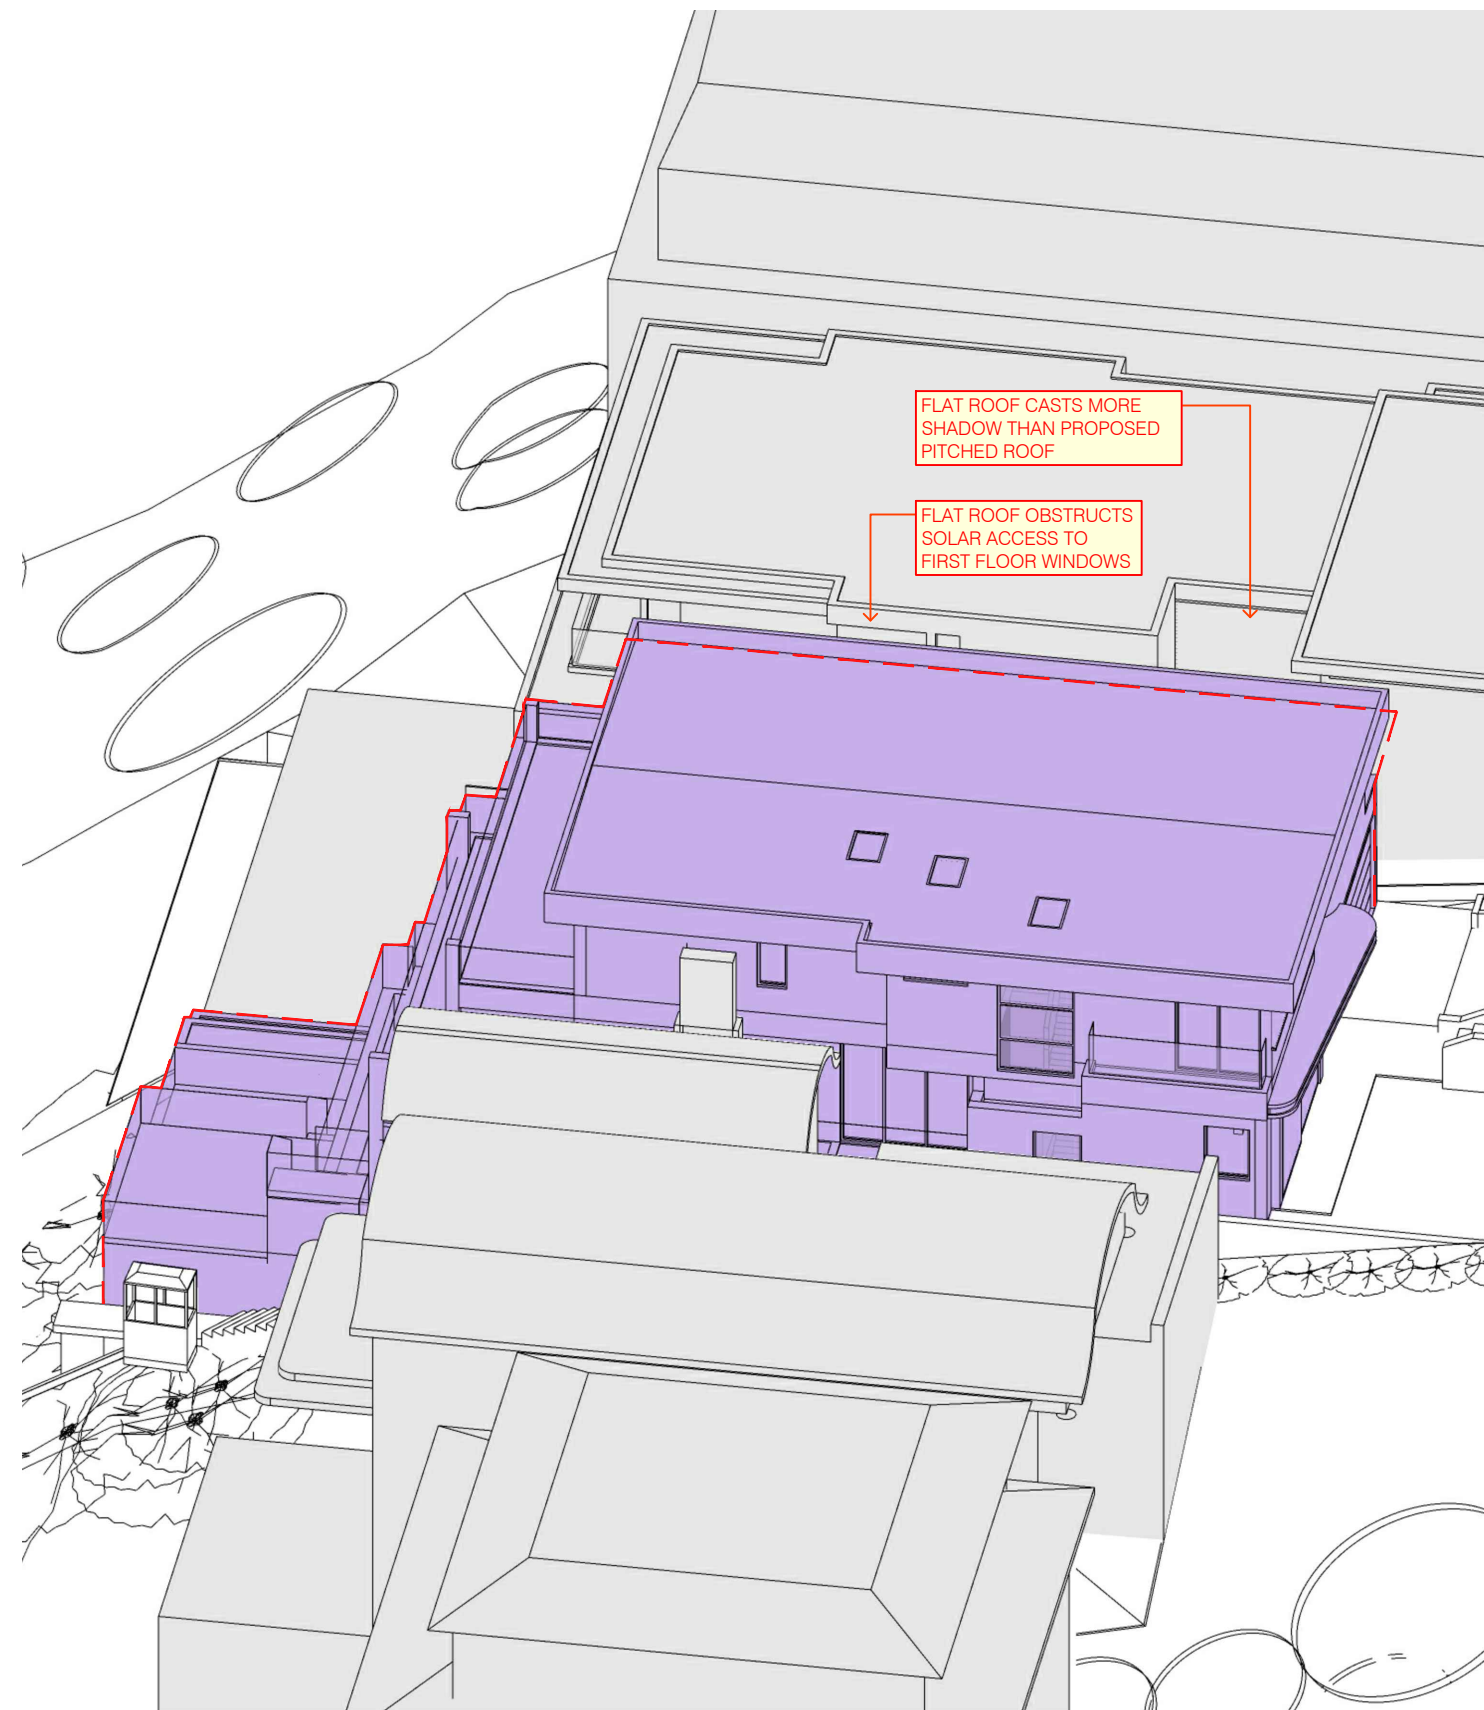

ALTERNATE: FLAT ROOF

S H A D O W   D I A G R A M S   -   W I N T E R   S O L S T I C E   -   2 2 n d   J U N E   1 2 P M

ARCHITECT



t: 02 8970 5417  
e: studio@bjbarchitects.com.au  
a: 3.09/77 Dunning Ave  
Rosebery NSW 2018

BJB Architects Pty Ltd  
Nominated Architect:  
Barry Babikian NSW Reg No 8806

LEGEND:



PROPOSED BUILDING



FLAT ROOF OPTION



RED DASHED LINE INDICATES  
EXTENT OF PROPOSED BUILDING/  
SHADOWS

ISSUE	AMENDMENT	DATE
E	Development Application	13.10.2020
F	DA Amendment	12.04.2021
G	Amendment - LEC	10.05.2022
H	Amendment - LEC	24.05.2022

PROJECT

75 COOLAWIN ROAD,  
NORTHBRIDGE  
NEW DWELLING

FLAT ROOF - SOLAR EYE DIAGRAMS

SCALE: NTS @ A3      DATE: 24.05.2022


ISSUE: H - Amendment - LEC

THIS DOCUMENT IS THE COPYRIGHT OF BJB ARCHITECTS.  
ALL INFORMATION ILLUSTRATED ON THIS DOCUMENT IS  
TO BE CHECKED AND VERIFIED ON SITE.  
IN THE EVENT OF DISCREPANCIES REFER TO BJB  
ARCHITECTS PRIOR TO COMMENCEMENT OF THE WORK.  
DO NOT SCALE DRAWINGS MANUALLY OR  
ELECTRONICALLY.


2020-031

A2013



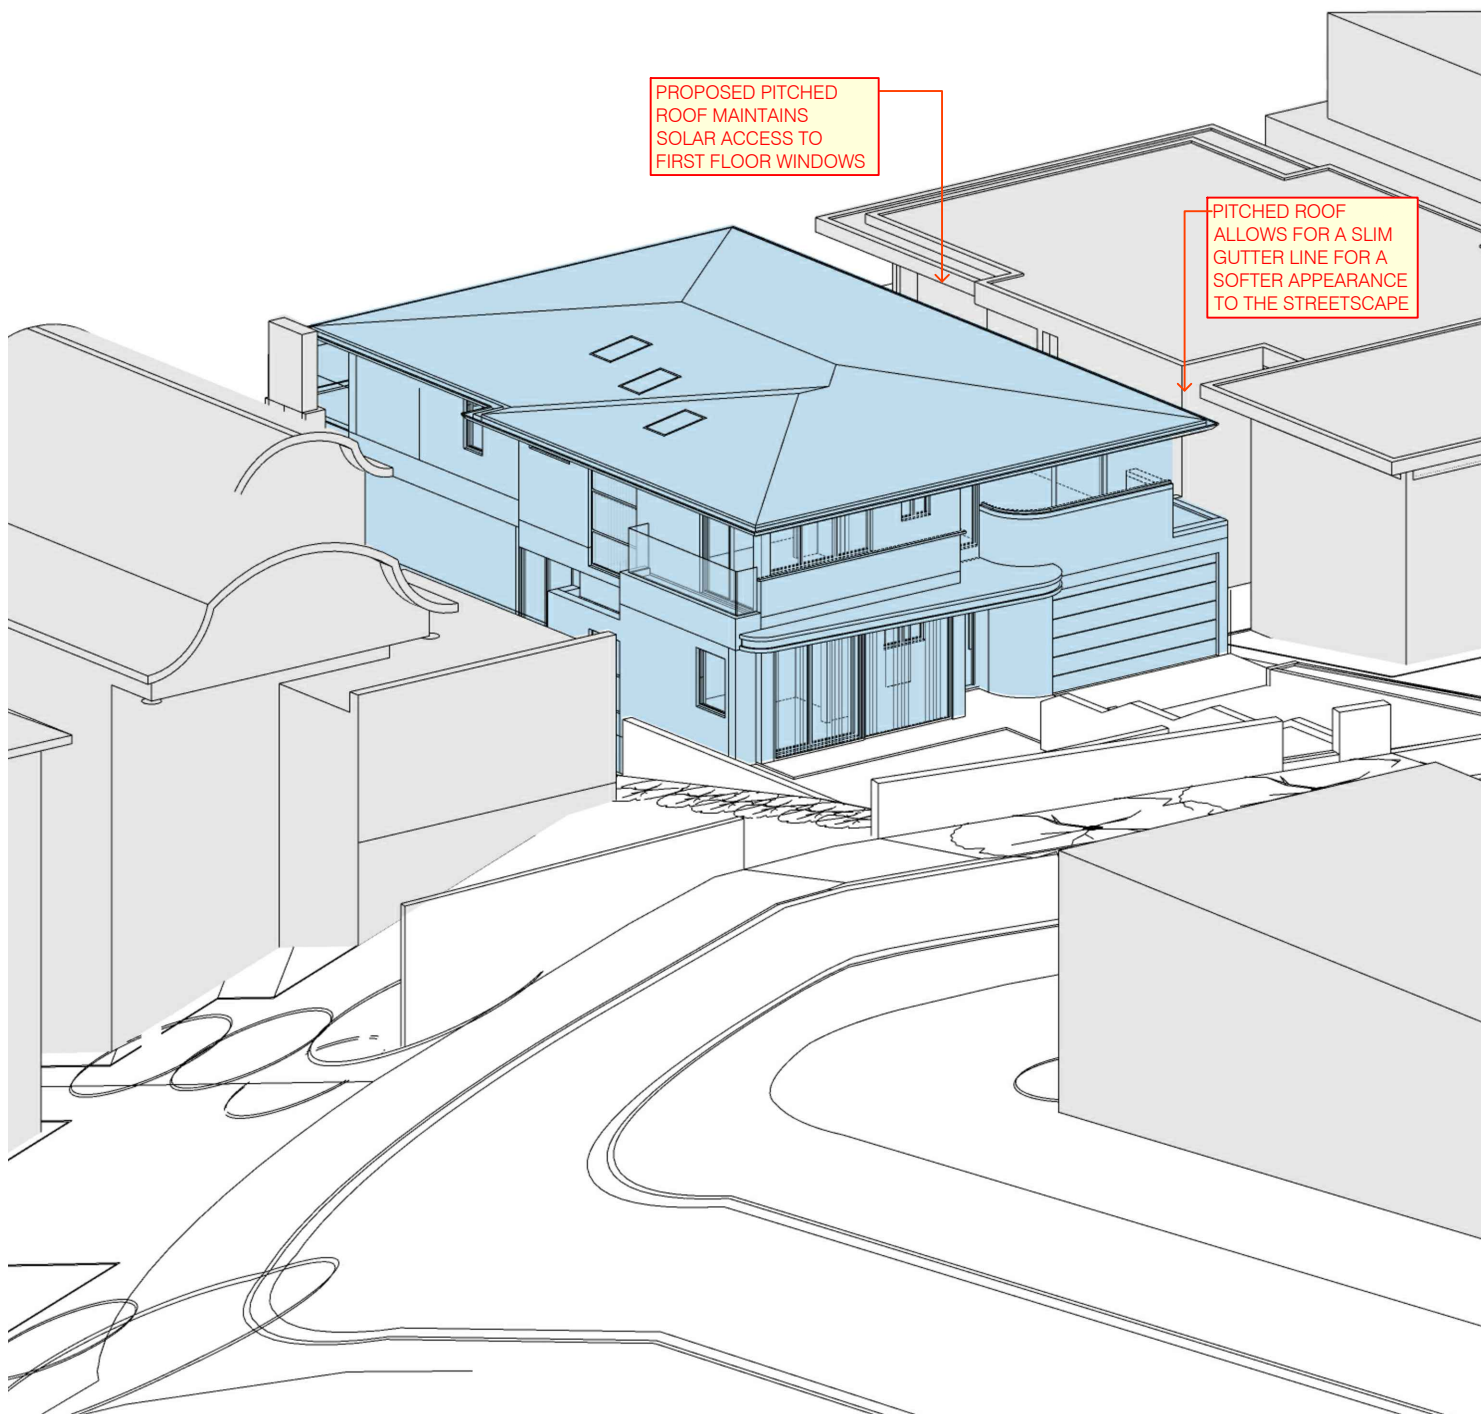

PROPOSED: PITCHED ROOF

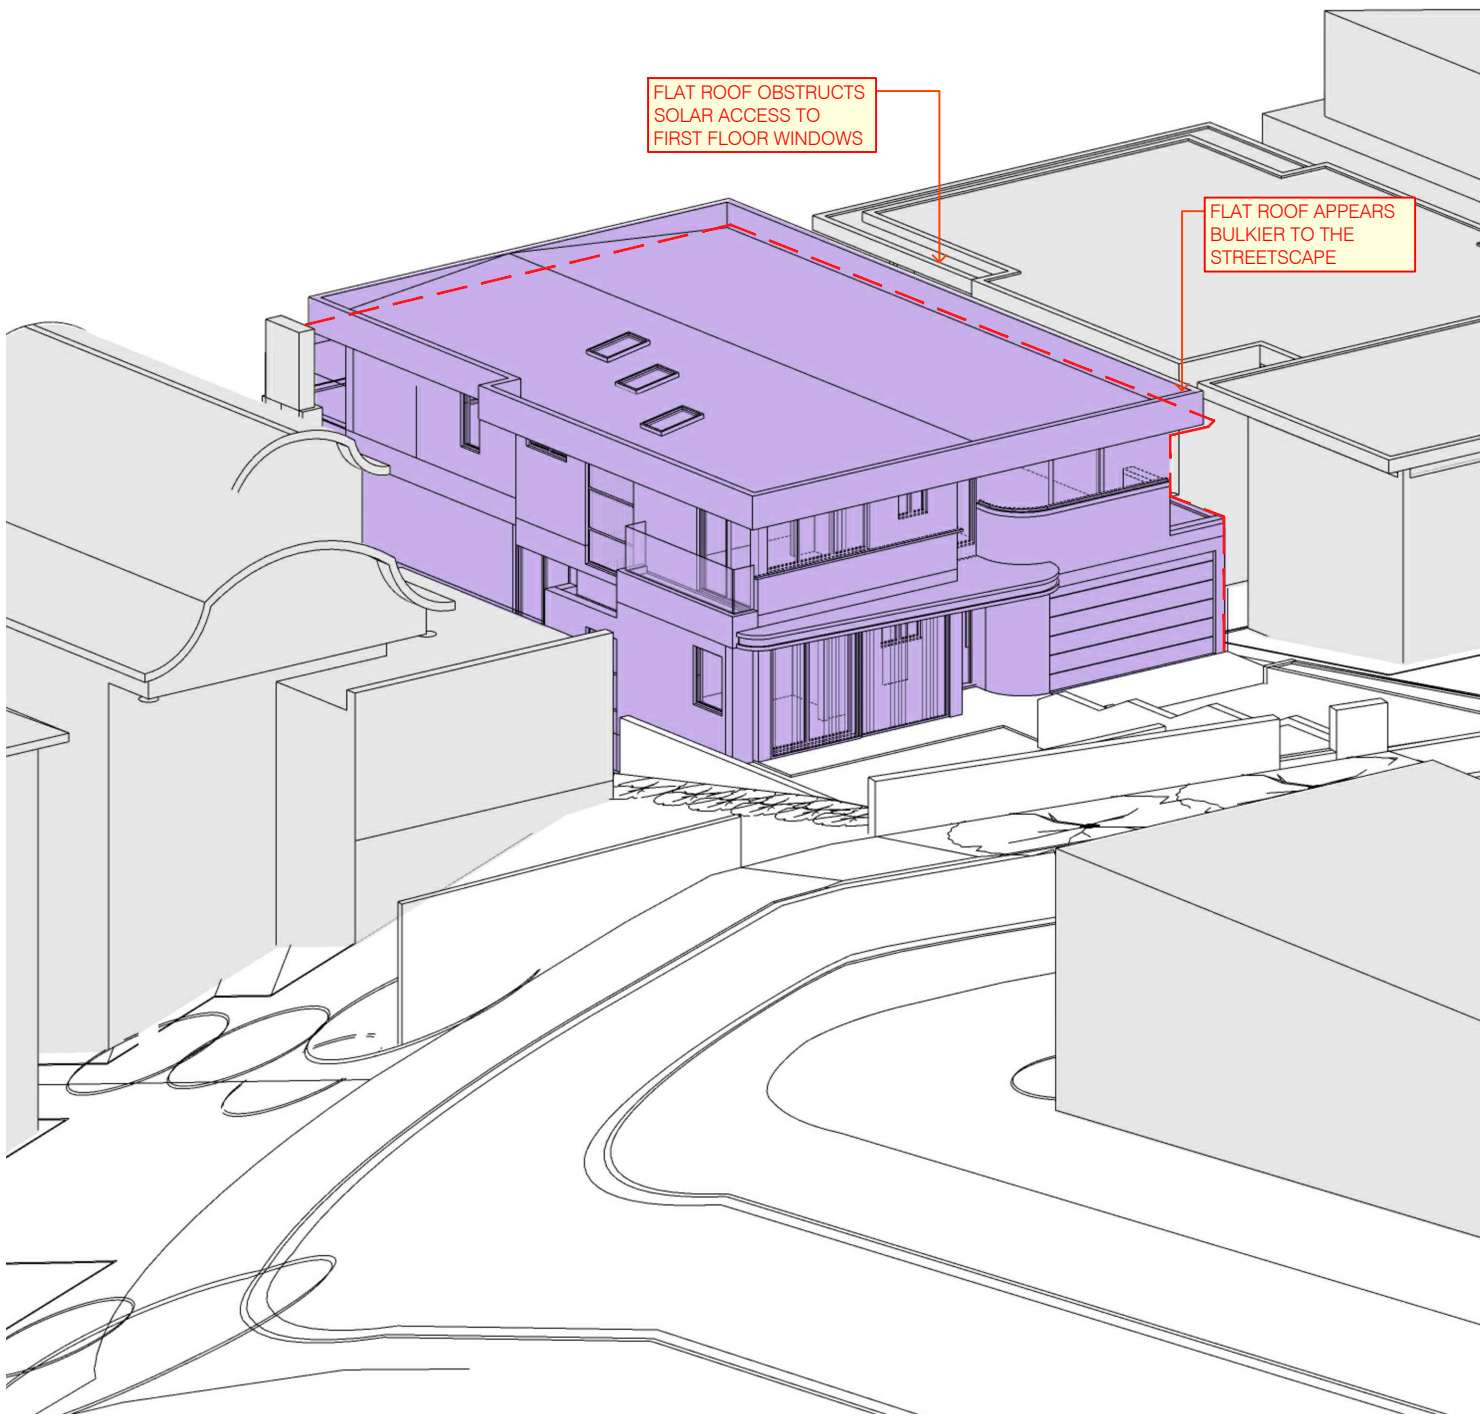

ALTERNATE: FLAT ROOF

S H A D O W   D I A G R A M S   -   W I N T E R   S O L S T I C E   -   2 2 n d   J U N E   3 P M


ARCHITECT





t: 02 8970 5417  
e: studio@bjbarchitects.com.au  
a: 3.09/77 Dunning Ave  
Rosebery NSW 2018

BJB Architects Pty Ltd  
Nominated Architect:  
Barry Babikian NSW Reg No 8806

LEGEND:

 PROPOSED BUILDING

 FLAT ROOF OPTION

 RED DASHED LINE INDICATES  
EXTENT OF PROPOSED BUILDING/  
SHADOWS

ISSUE	AMENDMENT	DATE
E	Development Application	13.10.2020
F	DA Amendment	12.04.2021
G	Amendment - LEC	10.05.2022
H	Amendment - LEC	24.05.2022

PROJECT

75 COOLAWIN ROAD,  
NORTHBRIDGE


NEW DWELLING

FLAT ROOF - SOLAR EYE DIAGRAMS

SCALE:   NTS @ A3                      DATE:   24.05.2022

ISSUE:   H - Amendment - LEC

THIS DOCUMENT IS THE COPYRIGHT OF BJB ARCHITECTS. ALL INFORMATION ILLUSTRATED ON THIS DOCUMENT IS TO BE CHECKED AND VERIFIED ON SITE. IN THE EVENT OF DISCREPANCIES REFER TO BJB ARCHITECTS PRIOR TO COMMENCEMENT OF THE WORK. DO NOT SCALE DRAWINGS MANUALLY OR ELECTRONICALLY.


 2020-031

A2014





ARCHITECT

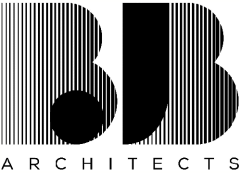

t: 02 8970 5417  
e: studio@bjbarchitects.com.au  
a: 3.09/77 Dunning Ave  
Rosebery NSW 2018

BJB Architects Pty Ltd  
Nominated Architect:  
Barry Babikian NSW Reg No 8806

ISSUE	AMENDMENT	DATE
E	Development Application	13.10.2020
F	DA Amendment	12.04.2021
G	Amendment - LEC	10.05.2022
H	Amendment - LEC	24.05.2022

PROJECT

75 COOLAWIN ROAD,  
NORTHBRIDGE


NEW DWELLING

STREETVIEW 3D	
SCALE:	DATE: 24.05.2022
ISSUE: H - Amendment - LEC	
<small>THIS DOCUMENT IS THE COPYRIGHT OF BJB ARCHITECTS. ALL INFORMATION ILLUSTRATED ON THIS DOCUMENT IS TO BE CHECKED AND VERIFIED ON SITE. IN THE EVENT OF DISCREPANCIES REFER TO BJB ARCHITECTS PRIOR TO COMMENCEMENT OF THE WORK. DO NOT SCALE DRAWINGS MANUALLY OR ELECTRONICALLY.</small>	
2020-031	
A3001	





ARCHITECT

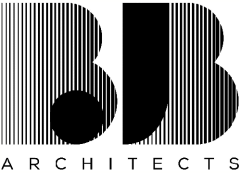

t: 02 8970 5417  
e: studio@bjbarchitects.com.au  
a: 3.09/77 Dunning Ave  
Rosebery NSW 2018


BJB Architects Pty Ltd  
Nominated Architect:  
Barry Babikian NSW Reg No 8806

ISSUE	AMENDMENT	DATE
E	Development Application	13.10.2020
F	DA Amendment	12.04.2021
G	Amendment - LEC	10.05.2022
H	Amendment - LEC	24.05.2022


PROJECT

**75 COOLAWIN ROAD,  
NORTHBRIDGE**

NEW DWELLING

STREETVIEW	
SCALE:	DATE: 24.05.2022
ISSUE: H - Amendment - LEC	
THIS DOCUMENT IS THE COPYRIGHT OF BJB ARCHITECTS. ALL INFORMATION ILLUSTRATED ON THIS DOCUMENT IS TO BE CHECKED AND VERIFIED ON SITE. IN THE EVENT OF DISCREPANCIES REFER TO BJB ARCHITECTS PRIOR TO COMMENCEMENT OF THE WORK. DO NOT SCALE DRAWINGS MANUALLY OR ELECTRONICALLY.	
	2020-031
A3002	




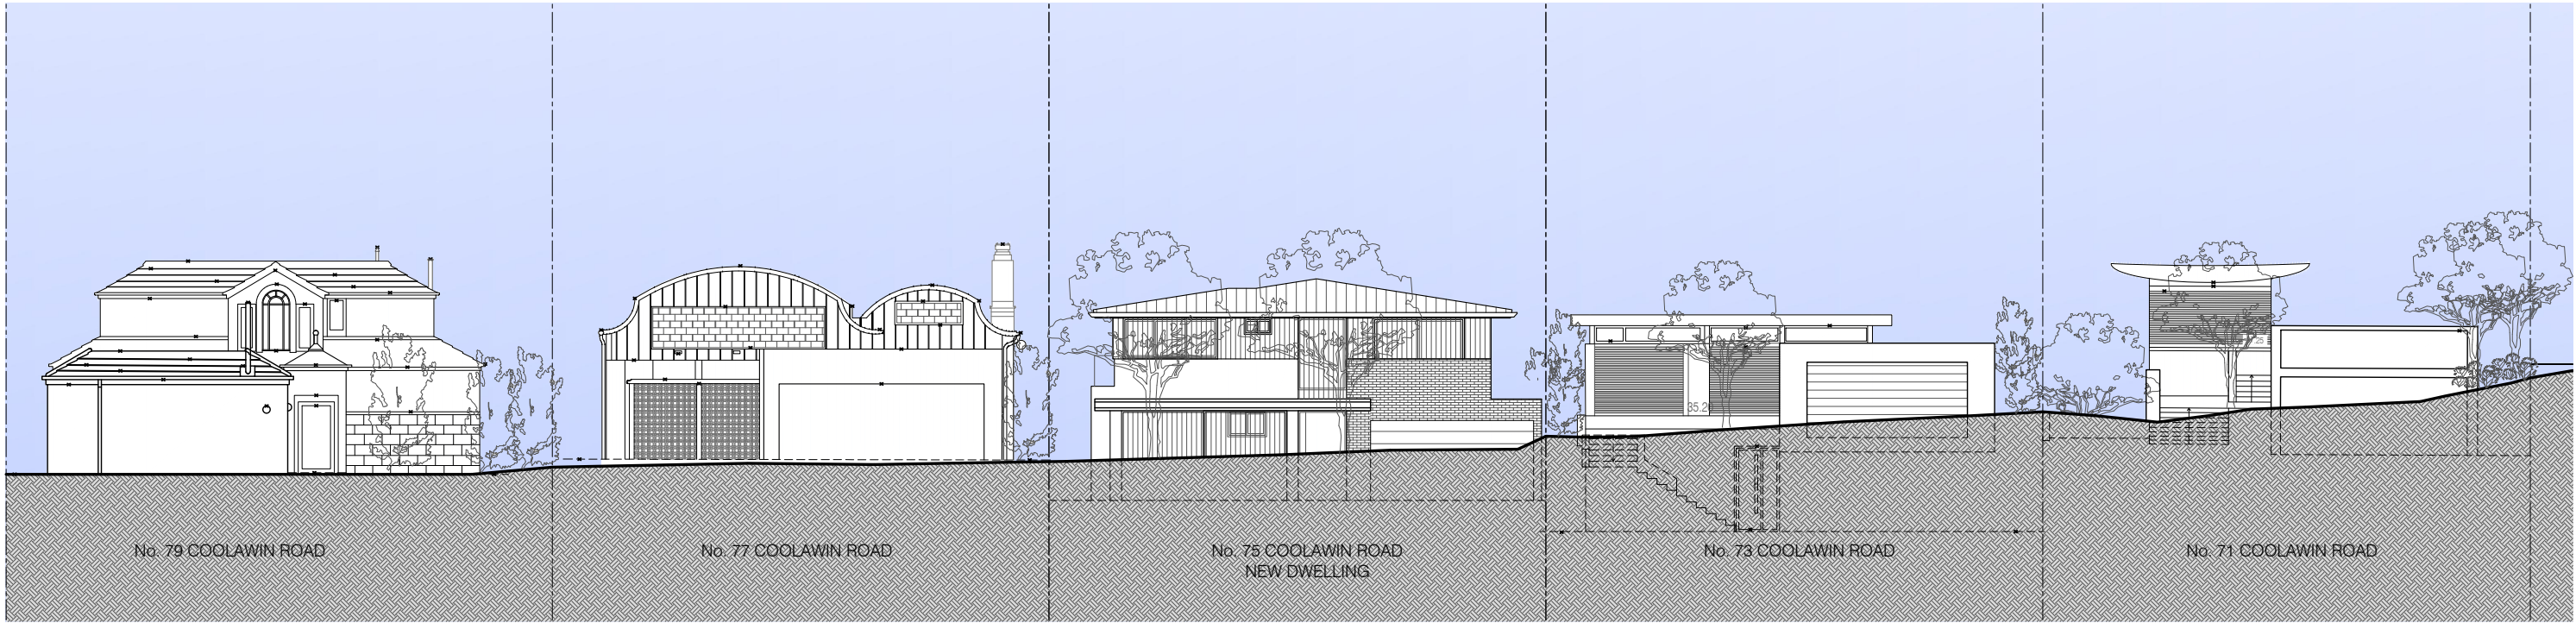

1  
3011

STREETSCAPE ELEVATION  
SCALE 1:200 @ A3

ARCHITECT

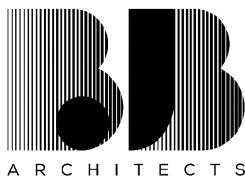


t: 02 8970 5417  
e: studio@bjbarchitects.com.au  
a: 3.09/77 Dunning Ave  
Rosebery NSW 2018

BJB Architects Pty Ltd  
Nominated Architect:  
Barry Babikian NSW Reg No 8806

LEGEND

----- DASHED LINE INDICATES EXTENT OF  
BUILDING BEHIND

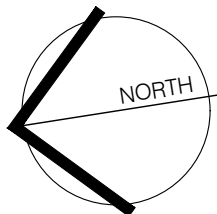

ISSUE	AMENDMENT	DATE
E	Development Application	13.10.2020
F	DA Amendment	12.04.2021
G	Amendment - LEC	10.05.2022
H	Amendment - LEC	24.05.2022

PROJECT

75 COOLAWIN ROAD,  
NORTHBRIDGE  
NEW DWELLING

STREETSCAPE ELEVATION


SCALE: 1:200 @ A3      DATE: 24.05.2022

ISSUE: H - Amendment - LEC

THIS DOCUMENT IS THE COPYRIGHT OF BJB ARCHITECTS.  
ALL INFORMATION ILLUSTRATED ON THIS DOCUMENT IS  
TO BE CHECKED AND VERIFIED ON SITE.  
IN THE EVENT OF DISCREPANCIES REFER TO BJB  
ARCHITECTS PRIOR TO COMMENCEMENT OF THE WORK.  
DO NOT SCALE DRAWINGS MANUALLY OR  
ELECTRONICALLY.


2020-031

A3011

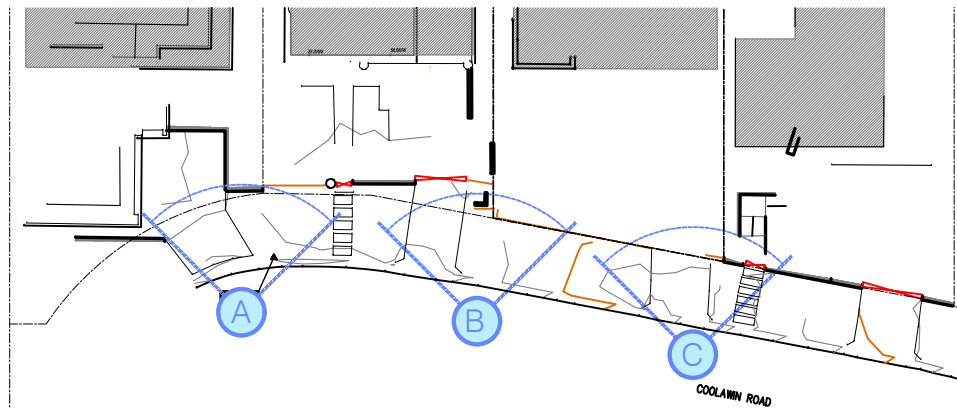

1 SITE PLAN  
SCALE 1:500 @ A3

ARCHITECT

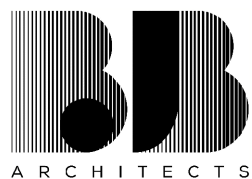


t: 02 8970 5417  
e: studio@bjbarchitects.com.au  
a: 3.09/77 Dunning Ave  
Rosebery NSW 2018

BJB Architects Pty Ltd  
Nominated Architect:  
Barry Babikian NSW Reg No 8806

LEGEND

----- DASHED LINE INDICATES EXTENT OF  
BUILDING BEHIND

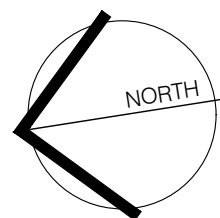

ISSUE	AMENDMENT	DATE
E	Development Application	13.10.2020
F	DA Amendment	12.04.2021
G	Amendment - LEC	10.05.2022
H	Amendment - LEC	24.05.2022

PROJECT

75 COOLAWIN ROAD,  
NORTHBRIDGE  
NEW DWELLING

STREETVIEW IMAGE - NO 77 & NO 79

SCALE: N.T.S. DATE: 24.05.2022


ISSUE: H - Amendment - LEC

THIS DOCUMENT IS THE COPYRIGHT OF BJB ARCHITECTS.  
ALL INFORMATION ILLUSTRATED ON THIS DOCUMENT IS  
TO BE CHECKED AND VERIFIED ON SITE.  
IN THE EVENT OF DISCREPANCIES REFER TO BJB  
ARCHITECTS PRIOR TO COMMENCEMENT OF THE WORK.  
DO NOT SCALE DRAWINGS MANUALLY OR  
ELECTRONICALLY.

2020-031


A3021



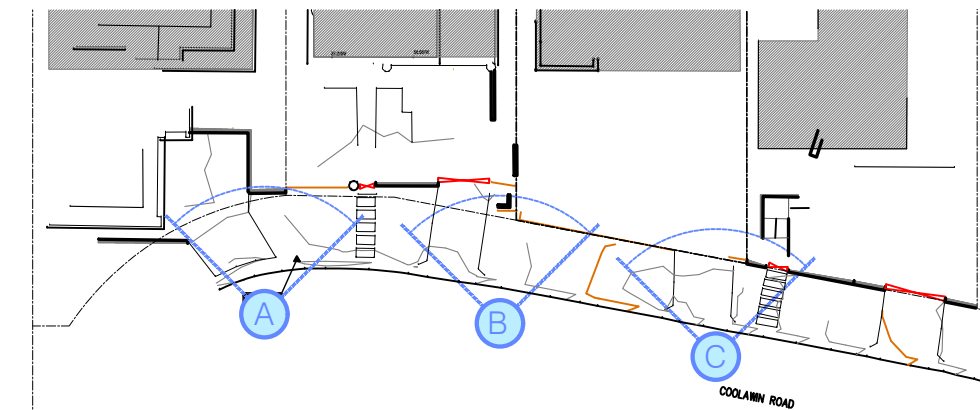

1 SITE PLAN  
SCALE 1:500 @ A3

ARCHITECT

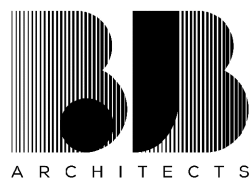


t: 02 8970 5417  
e: studio@bjbarchitects.com.au  
a: 3.09/77 Dunning Ave  
Rosebery NSW 2018

BJB Architects Pty Ltd  
Nominated Architect:  
Barry Babikian NSW Reg No 8806

LEGEND

----- DASHED LINE INDICATES EXTENT OF  
BUILDING BEHIND

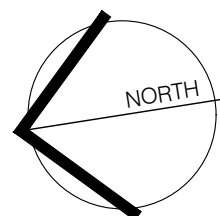

ISSUE	AMENDMENT	DATE
E	Development Application	13.10.2020
F	DA Amendment	12.04.2021
G	Amendment - LEC	10.05.2022
H	Amendment - LEC	24.05.2022

PROJECT

75 COOLAWIN ROAD,  
NORTHBRIDGE  
NEW DWELLING

STREETVIEW IMAGE - NO 77 & NO 75

SCALE: N.T.S. DATE: 24.05.2022


ISSUE: H - Amendment - LEC

THIS DOCUMENT IS THE COPYRIGHT OF BJB ARCHITECTS.  
ALL INFORMATION ILLUSTRATED ON THIS DOCUMENT IS  
TO BE CHECKED AND VERIFIED ON SITE.  
IN THE EVENT OF DISCREPANCIES REFER TO BJB  
ARCHITECTS PRIOR TO COMMENCEMENT OF THE WORK.  
DO NOT SCALE DRAWINGS MANUALLY OR  
ELECTRONICALLY.

2020-031


A3022



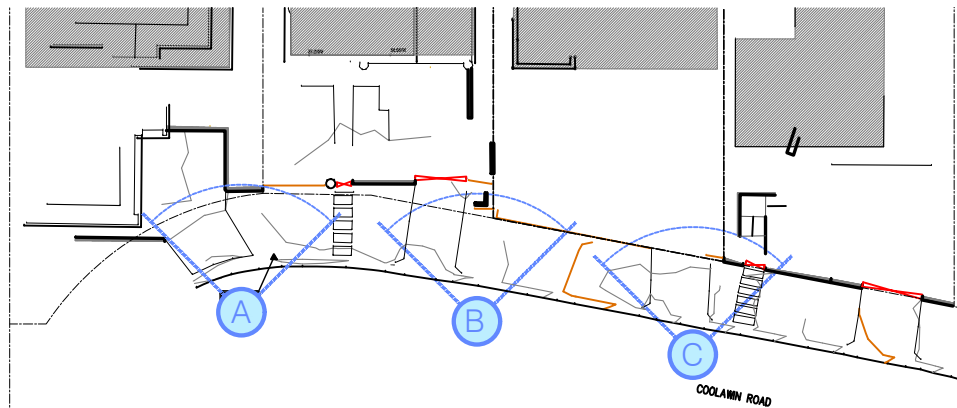

1 SITE PLAN  
SCALE 1:500 @ A3

ARCHITECT

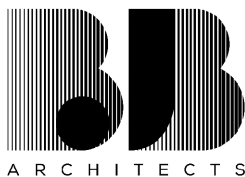


t: 02 8970 5417  
e: studio@bjbarchitects.com.au  
a: 3.09/77 Dunning Ave  
Rosebery NSW 2018

BJB Architects Pty Ltd  
Nominated Architect:  
Barry Babikian NSW Reg No 8806

LEGEND

----- DASHED LINE INDICATES EXTENT OF  
BUILDING BEHIND

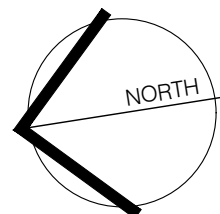

ISSUE	AMENDMENT	DATE
E	Development Application	13.10.2020
F	DA Amendment	12.04.2021
G	Amendment - LEC	10.05.2022
H	Amendment - LEC	24.05.2022

PROJECT

75 COOLAWIN ROAD,  
NORTHBRIDGE  
NEW DWELLING

STREETVIEW IMAGE - NO 75 & NO 73

SCALE: N.T.S. DATE: 24.05.2022

ISSUE: H - Amendment - LEC

THIS DOCUMENT IS THE COPYRIGHT OF BJB ARCHITECTS.  
ALL INFORMATION ILLUSTRATED ON THIS DOCUMENT IS  
TO BE CHECKED AND VERIFIED ON SITE.  
IN THE EVENT OF DISCREPANCIES REFER TO BJB  
ARCHITECTS PRIOR TO COMMENCEMENT OF THE WORK.  
DO NOT SCALE DRAWINGS MANUALLY OR  
ELECTRONICALLY.

2020-031

A3023