


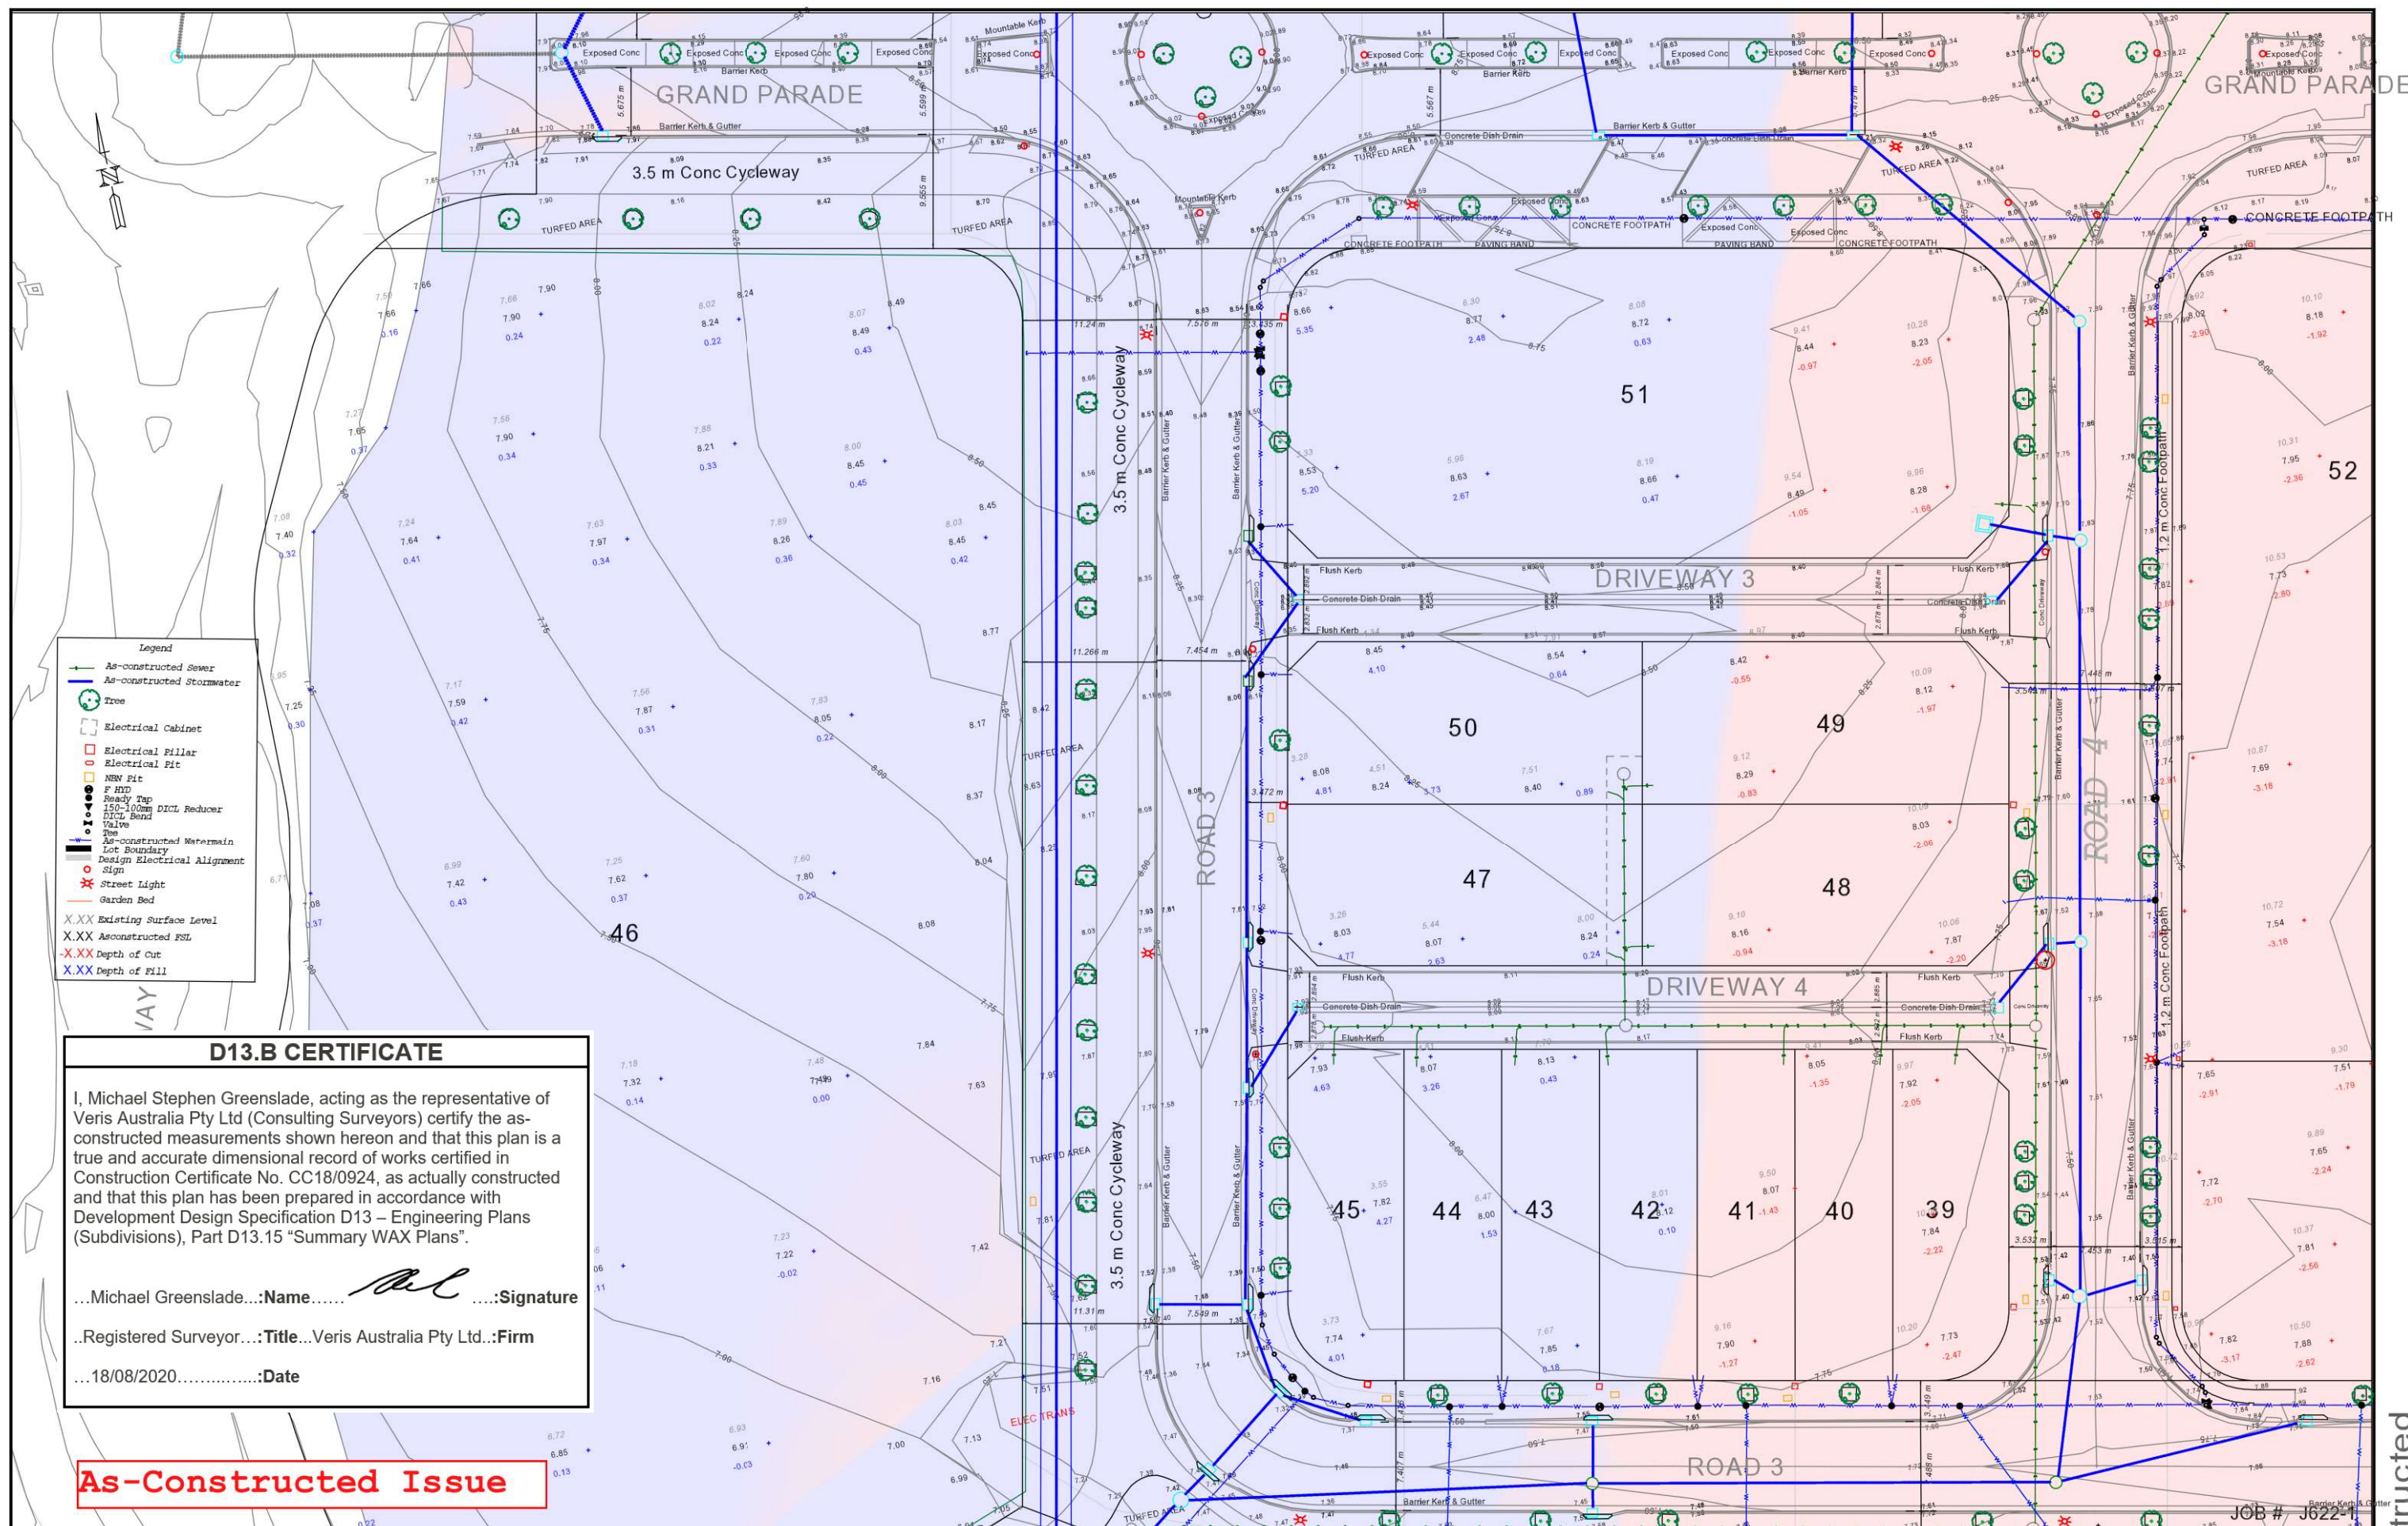

NOTES & DISCLAIMERS		TWEED SHIRE COUNCIL		SURVEYED: SB VERT. DATUM: AHD(D) HORIZ DATUM: MGA56 DRAWN: MF APPROVED: CONTOUR INTERVAL: 0.1 SCALE 1:500 at A3		CONSTRUCTING THE FUTURE ON THE STRENGTH OF OUR PAST see Civil Pty Ltd Issue Date: 17/06/2020 Revision Date: N/A		CASUARINA BEACH TOWN CENTRE- STAGES 1D & 1E CASUARINA WAY, NSW 2487 SITE PLAN AS-CONSTRUCTED SHEET 5 OF 8 DRG No. ASC_DWG_622-1_001 P:622-1 Casuarina Town Centre Stage 2s	
- Drawn to scale on an A3 sheet - Dimensions in meters unless noted otherwise - Boundary information compiled from data provided by Principal - Services shown in as-constructed location unless noted otherwise - Electrical Alignment is Shown Indicative Only. No Survey on Electrical Alignment, Feature Locations Only		A		Original Issue		29/06/2020			
REVISION				AMENDMENTS		DATE			